


STATE OF KANSAS  
STATE CORPORATION COMMISSION  
200 Colorado Derby Bldg.  
Wichita, Kansas 67202

Form CP-4  
Rev. 12-15-80

WELL PLUGGING RECORD

Give All Information Completely  
Make Required Affidavit

COUNTY Barber SEC. 5 TWP. 33S RGE. 11 NW  
Location as in quarters or footage from lines:  
NW NE NE

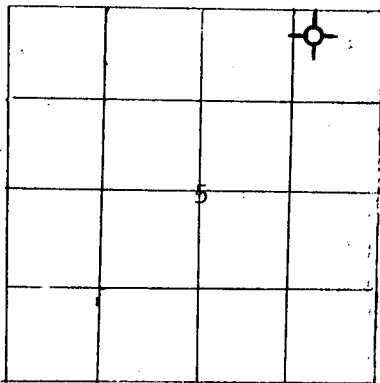

Locate Well  
correctly on above  
Section Platt.

Lease Owner Wild Boys & The Silver Bullet  
Lease Name WORTMAN 'S' Well No. 10  
Office Address 815 N. Waco, Suite 3A, Wichita, Ks.  
Character of Well (Completed as Oil, Gas or Dry Hole): Dry  
Date Well Completed 12-15-81  
Application for plugging filed February 3, 1982  
Plugging commenced 12-15-81  
Plugging completed 12-15-81  
Reason for abandonment of well or producing formation Non-commercial

Was permission obtained from the Conservation Division or it's  
Agent's before plugging was commenced? Yes

Name of Conservation Agent who supervised plugging of this well Maurice Leslie  
Producing formation N/A Depth to top          bottom T.D. 5000'  
Show depth and thickness of all water, oil and gas formations.

OIL, GAS OR WATER RECORDS

Casing Record

Formation	Content	From	To	Size	Put in	Pulled Out
Heebner		3603		8 5/8"	421'	
Douglas		3726'				
Lansing		3767'				
Mississippi		4408'				
Arbuckle		4944'				

Describe in detail the manner in which the well was plugged, indicating where the mud fluid was placed and the method or methods used in introducing it into the hold. If cement or other plugs were used, state the character of same and depth placed, from          feet to          feet for each plug set.

60 sx at 820', 40 sx at 420', bridge plug and 10 sx at 40', 10 sx in rathole, 5 sx in Mousehole. Common Cement + 2% Gel + 3% CaCl2 pumped into place. Cement plug from 820'-650', cement plug from 420' to 305', wooden plug at 40' and cement to surface. Mud fluids are left in pits and backfilled in place when sufficiently dry.

(If additional description is necessary, use BACK of this sheet)

Name of Plugging Contractor Allied Cementing Co., Inc.

STATE OF Kansas COUNTY OF Sedgwick, ss.

R. A. Christensen (employee of owner) or (~~owner or operator~~) of the above-described well, being first duly sworn on oath, says: That I have knowledge of the facts, statements, and matters herein contained and the log of the above-described well as filed and that the same are true and correct. So help me God.

(Signature) [Handwritten Signature]  
(Address)         

SUBSCRIBED AND SWORN TO before me this 3rd day of February, 19 82

My Commission expires: October 29, 1984

DONNA HALE ARD  
STATE NOTARY PUBLIC  
SEDGWICK COUNTY, KANSAS

RECEIVED  
STATE CORPORATION COMMISSION  
FEB - 4 1982  
CONSERVATION DIVISION  
Wichita, Kansas