

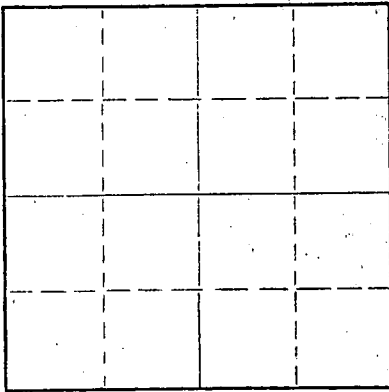
STATE OF KANSAS
STATE CORPORATION COMMISSION

Form CP-4

Give All Information Completely
Make Required Affidavit
Mail or Deliver Report to:
Conservation Division
State Corporation Commission
211 No. Broadway
Wichita, Kansas

WELL PLUGGING RECORD

NORTH

Locate well correctly on above
Section Plat

Barber County. Sec. 6 Twp. 33S Rge. 11W (E) (W)
Location as "NE/CNW/SW" or footage from lines Approx. C. SW/4 SW/4
Lease Owner Sioux Petroleum Co.
Lease Name Drum 'A' Well No. 1
Office Address Drawer 270, Medicine Lodge, Kansas
Character of Well (completed as Oil, Gas or Dry Hole) Dry Hole
Date well completed March 29 19 67
Application for plugging filed March 29 19 67
Application for plugging approved March 29 19 67
Plugging commenced March 29 19 67
Plugging completed March 29 19 67
Reason for abandonment of well or producing formation Dry Hole

If a producing well is abandoned, date of last production 19
Was permission obtained from the Conservation Division or its agents before plugging was commenced? Yes

Name of Conservation Agent who supervised plugging of this well Archie V. Elving, Pratt, Kansas
Producing formation _____ Depth to top _____ Bottom _____ Total Depth of Well 3600 Feet
Show depth and thickness of all water, oil and gas formations.

OIL, GAS OR WATER RECORDS

CASING RECORD

FORMATION	CONTENT	FROM	TO	SIZE	PUT IN	PULLED OUT
		0	215'	8 5/8"	215'	None

Describe in detail the manner in which the well was plugged, indicating where the mud fluid was placed and the method or methods used in introducing it into the hole. If cement or other plugs were used, state the character of same and depth placed, from _____ feet to _____ feet for each plug set.

Set Plug: 200'/25 sacks cement & 1/4 sack hulls
40'/10 sacks cement & 1/4 sack hulls

RECEIVED
STATE CORPORATION COMMISSION

APR 3 1967

CONSERVATION DIVISION
Wichita, Kansas

(If additional description is necessary, use BACK of this sheet)

Name of Plugging Contractor Hellar Drilling Company, Inc.
Address 1014 Union Center, Wichita, Kansas 67202

STATE OF Kansas, COUNTY OF Sedgwick, ss.
D.L. Hellar, Pres. of Hellar Drilling Company, Inc.

(employee of owner) or (owner or operator) of the above-described well, being first duly sworn on oath, says: That I have knowledge of the facts, statements, and matters herein contained and the log of the above-described well as filed and that the same are true and correct. So help me God.

(Signature) D. L. Hellar D. L. Hellar, President

1014 Union Center, Wichita, Kansas 67202
(Address)

SUBSCRIBED AND SWORN TO before me this 31st day of March, 19 67

My commission expires March 25, 1968

Catherine Darcey - Notary Public.

DRILLER'S LOG

COMPANY: Sioux Petroleum Co., Drawer 270, Medicine Lodge, Kansas
CONTRACTOR: Hellar Drilling Company, Inc., Wichita, Kansas
LEASE: #1 Drum 'A'
LOCATION: Approx. C. SW/4 SW/4 6-33S-11W, Barber County, Kansas
COMMENCED: March 22, 1967
COMPLETED: March 29, 1967
CASING: Set 8 5/8" surface casing @ 215'/210 sacks cement

0-215	Red Bed
215-1320	Shale & Shells
1320-1617	Shale & Salt Section
1617-1844	Salt Section & Cherty Lime
1844-1946	Cherty Lime
1946-2745	Lime & Shale
2745-2801	Shale & Lime
2801-2885	Lime
2885-3055	Lime & Shale
3055-3300	Shale & Lime
3300-3470	Lime & Shale
3470-3562	Shale
3562-3600	Sand & Lime
3600	Rotary Total Depth

D & A

RECEIVED
STATE CORPORATION COMMISSION
APR 3 1967
CONSERVATION DIVISION
WICHITA, KANSAS

STATE OF KANSAS)
) SS
COUNTY OF SEDGWICK)

I, D. L. Hellar, do hereby certify that the above and foregoing is a true and correct copy of the log of the #1 Drum 'A', located Approx. C SW/4 SW/4 Sec. 6-33S-11W, Barber County, Kansas, as reflected by the files of the Hellar Drilling Company, Inc.

HELLAR DRILLING COMPANY, INC.

BY *D. L. Hellar*
President D. L. Hellar

Subscribed and sworn to before me, a Notary Public, in and for Sedgwick County, Kansas, this 31st day of March, 1967.

Catherine Darcey
Notary Public - Catherine Darcey

My Commission Expires:
March 25, 1968.