


Give All Information Completely
Make Required Affidavit
Mail or Deliver Report to:
Conservation Division
State Corporation Commission
211 No. Broadway
Wichita, Kansas

WELL PLUGGING RECORD

NORTH

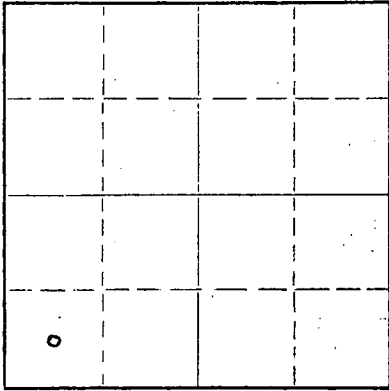

Locate well correctly on above
Section Plat

Barber County, Sec. 26 Twp. 30 Rge. 14 (E) W (W)

Location as "NE/CNW%SW%" or footage from lines C SW SW
Lease Owner Thunderbird Drilling, Inc.
Lease Name Lambert Well No. 1
Office Address 712 Union Center, Wichita, Kansas
Character of Well (completed as Oil, Gas or Dry Hole) Dry Hole
Date well completed December 23, 19 64
Application for plugging filed December 23, 19 64
Application for plugging approved December 23, 19 64
Plugging commenced December 23, 19 64
Plugging completed December 23, 19 64
Reason for abandonment of well or producing formation Dry Hole

If a producing well is abandoned, date of last production 19
Was permission obtained from the Conservation Division or its agents before plugging was commenced? Yes

Name of Conservation Agent who supervised plugging of this well Archie Elving
Producing formation _____ Depth to top _____ Bottom _____ Total Depth of Well 4760 Feet
Show depth and thickness of all water, oil and gas formations.

OIL, GAS OR WATER RECORDS

CASING RECORD

FORMATION	CONTENT	FROM	TO	SIZE	PUT IN	PULLED OUT

Describe in detail the manner in which the well was plugged, indicating where the mud fluid was placed and the method or methods used in introducing it into the hole. If cement or other plugs were used, state the character of same and depth placed, from _____ feet to _____ feet for each plug set.

Plug with 1/2 sack hulls - 25 sacks cement @ 260'
Finish plugging hole
Top plug @ 40' with 10 sacks cement to bottom of cellar

RECEIVED
STATE CORPORATION COMMISSION

JAN 14 1965

1-14-65

CONSERVATION DIVISION
Wichita, Kansas

(If additional description is necessary, use BACK of this sheet)

Name of Plugging Contractor Thunderbird Drilling, Inc.
Address 712 Union Center, Wichita, Kansas

STATE OF KANSAS, COUNTY OF SEDGWICK ss.
Charles W. Aikins, Jr. (employee or owner) or (owner or operator) of the above-described well, being first duly sworn on oath, says: That I have knowledge of the facts, statements, and matters herein contained and the log of the above-described well as filed and that the same are true and correct. So help me God.


(Signature) Charles W. Aikins, Jr., President
712 Union Center, Wichita, Kansas
(Address)

SUBSCRIBED AND SWORN TO before me this 28th day of December, 1964

My commission expires

8-24-68

Cara Lou Smith
Cara Lou Smith Notary Public.

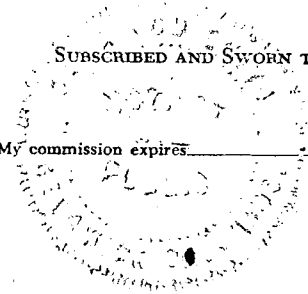

DRILLERS LOG

#1 Lambert

LOCATION:

C SW SW of Section 26,
Township 30 South, Range 14 West,
Barber County, Kansas

CONTRACTOR:

Thunderbird Drilling, Inc.
712 Union Center
Wichita 2, Kansas

COMMENCED:

December 8, 1964

COMPLETED:

December 23, 1964

SURFACE CASING:

8-5/8" surface casing set at 275'
with 200 sacks cement, 1% gel,
3 sacks ammonia chloride, 3 sacks
calcium chloride.

ELEVATION:

1844' K. B.
1841' D. F.
1839' G. L.


WELL LOG:

0 -	40	Surface Clay
40 -	400	Red Bed
400 -	1130	Red Bed & Shale
1130 -	1251	Shale & Shells
1251 -	1615	Shale
1615 -	1640	Anhydrite
1640 -	1800	Shale & Lime
1800 -	2075	Lime & Shale
2075 -	2260	Lime
2260 -	3000	Lime & Shale
3000 -	3130	Shale & Lime
3130 -	3265	Lime & Shale
3265 -	3365	Lime
3365 -	3520	Lime & Shale
3520 -	3690	Lime
3690 -	3813	Lime & Shale
3813 -	3943	Sand & Shale
3943 -	3995	Lime & Shale
3995 -	4535	Lime
4535 -	4638	Chert & Lime
4638 -	4660	Shale & Lime
4660 -	4665	Sand
4665 -	4730	Sand & Lime
4730 -	4760	Lime
4760		Rotary Total Depth


RECEIVED
STATE CORPORATION COMMISSION
JAN 15 1965
1-15-65
CONSERVATION DIVISION
Wichita, Kansas

The undersigned, Charles W. Aikins, Jr., an officer of Thunderbird Drilling, Inc., hereby certifies that the above is a true and correct log of the formations encountered in the drilling of the #1 Lambert as shown in the daily drilling reports.

THUNDERBIRD DRILLING, INC.


Charles W. Aikins, Jr., President

Subscribed and sworn to before me this 6th day of January, 1965.

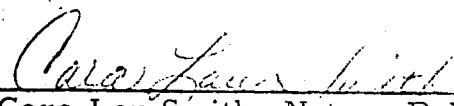
Cara Lou Smith, Notary Public

My commission expires 8-24-68.

