


STATE OF KANSAS
STATE CORPORATION COMMISSION

WELL PLUGGING RECORD

Give All Information Completely
Make Required Affidavit
Mail or Deliver Report to:
Conservation Division
State Corporation Commission
800 Bitting Building
Wichita, Kansas

Barber County, Sec. 29 Twp. 30 Rge. (E) 14 (W)
Location as "NE/CNW $\frac{1}{4}$ SW $\frac{1}{4}$ " or footage from lines NE NW SE
Lease Owner R. C. Patton and others
Lease Name Werner Well No. 1
Office Address 612 Orpheum Bldg. Wichita 2, Kansas.
Character of Well (completed as Oil, Gas or Dry Hole) Dry Hole
Date well completed 9/19 1955
Application for plugging filed 9/18 19 55
Application for plugging approved 9/19 19 55
Plugging commenced 9/19 19 55
Plugging completed 9/19 19 55
Reason for abandonment of well or producing formation

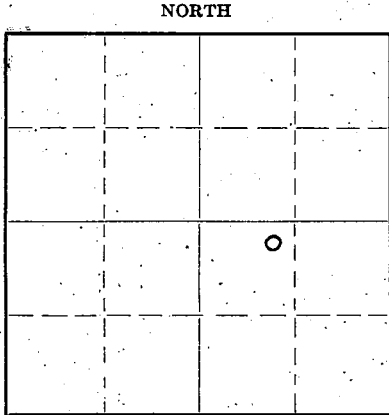

Locate well correctly on above
Section Plat

If a producing well is abandoned, date of last production 19
Was permission obtained from the Conservation Division or its agents before plugging was commenced? Yes

Name of Conservation Agent who supervised plugging of this well N. A. Rives
Producing formation Depth to top Bottom Total Depth of Well 4665 Feet
Show depth and thickness of all water, oil and gas formations.

OIL, GAS OR WATER RECORDS

CASING RECORD

Formation	Content	From	To	Size	Put In	Pulled Out
				8 5/8	794'	None

Describe in detail the manner in which the well was plugged, indicating where the mud fluid was placed and the method or methods used in introducing it into the hole. If cement or other plugs were used, state the character of same and depth placed, from feet to feet for each plug set.

Filled hole to 350' with Heavy Mud, Set Bridge Plug at 350' 35 sacks cement thru Drill Pipe, Heavy mud up to 40' Set Bridge Plug at 40' 15 Sacks cement up to bottom of celler, Used Halliburton.

(If additional description is necessary, use BACK of this sheet)

Correspondence regarding this well should be addressed to R. C. Patton Co.,
Address 612 Orpheum Bldg. Wichita 2, Kansas.

STATE OF Kansas COUNTY OF Sedgwick ss.
Roberts W. Patton (employee of owner) of the above-described well,
being first duly sworn on oath; says: That I have knowledge of the facts, statements, and matters herein contained and the log of the above-described well as filed and that the same are true and correct. So help me God.

(Signature) Robert W. Patton
612 Orpheum Bldg. Wichita 2, Kansas
(Address)

SUBSCRIBED AND SWORN to before me this 26th day of September 19 55
Notary Public.

My commission expires October 4th 1955

22-5133-s

9-48-10M

RECEIVED
STATE CORPORATION COMMISSION

SEP 29 1955
9-29-55
CONSERVATION DIVISION
Wichita, Kansas

PLUGGING
FILE SEC 29 T 30 R 14 W
BOOK PAGE 2 LINE 12

R. C. Patton Co., and Others.
 Werner Well #1
 Comm. 8/29/55
 Comp. 9/19/55
 Contractor R. C. Patton Co.,

Location NE NW SE Section 29-T30S-R14W
 Barber County, Kansas.
 CASING RECORD
 8 5/8" Casing at 794'
 Cemented with 250 Sack Pozmix and 100
 Sack Reg Cement

Red Bed	65
Red Bed & Shells	700
Anhydrite	755
Shale & Shells	1290
Soft Shale & Shells	1350
Shale, Anhydrite & Shells	1500
Shale & Shells	1625
Shale & Lime	2070
Lime	2490
Shale & Shells	2555
Shale & Lime	2755
Shale & Shells	2765
Sandy Shale	3107
Lime 3775	3775
Shale & Lime	3939
Lime	4455
Chert & Lime	4532
Sand & Lime	4533
Sand	4539
Sand & Shale	4563
Sand	4573
Sand & Shale	4644
Chert & Lime	4665
Total Depth	4665

Elevation	1832 G.L.
TOPS	
Top Heebner Shale	3770
Top Toronto Lime	3789
Top Douglas Shale	3817
Top Douglas Sand	3922
Top Brown Lime	3940
Top Lansing-Kansas City	3955
Base Kansas City	4344
Top Basal Penn. Cong.	4438
Top Viola Chert	4448
Top Simpson (Sand)	4532
Top Arbuckle Dolomite	4645

STATE OF Kansas COUNTY OF Sedgewick ss.

I, the undersigned, being duly sworn, on oath state that the above statement and log is a true and correct record and log of the well drilled at the location above described.

RECEIVED
 STATE CORPORATION COMMISSION
 SEP 27 1955
 9-27-55
 CONSERVATION DIVISION
 Wichita, Kansas

R. C. PATTON CO.,

By Robert W. Patton

Subscribed and sworn to before me this 26th day of September 1955

J. P. Wundrich
 Notary Public.

My Commission expires Oct 4th 1956

PLUGGING
 FILE SEC 29 T 30 R 14W
 BOOK PAGE a LINE 17