


15-007-00170-00-01

STATE OF KANSAS
STATE CORPORATION COMMISSION

WELL PLUGGING RECORD

Give All Information Completely
Make Required Affidavit
Mail or Deliver Report to:
Conservation Division
State Corporation Commission
212 North Market, Insurance Bldg.
Wichita, Kansas

Barber County, Sec. 29 Twp. 30S Rge. 14 (E) X (W)

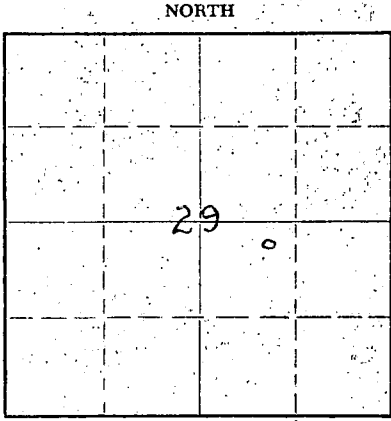

Locate well correctly on above
Section Plat

Location as "NE/CNW/SW" or footage from lines: NE NW SE
Lease Owner Ferguson Oil Company
Lease Name Werner-Lambert Well No. 1
Office Address 522 Union Center Building, Wichita, Kansas
Character of Well (completed as Oil, Gas or Dry Hole) Dry Hole (OWWO)
Date well completed 4-30 19 65
Application for plugging filed 4-30 19 65
Application for plugging approved 4-30 19 65
Plugging commenced 4-30 19 65
Plugging completed 4-30 19 65
Reason for abandonment of well or producing formation Dry Hole

If a producing well is abandoned, date of last production 19
Was permission obtained from the Conservation Division or its agents before plugging was commenced? Yes

Name of Conservation Agent who supervised plugging of this well Herman Justus
Producing formation _____ Depth to top _____ Bottom _____ Total Depth of Well 4550 Feet
Show depth and thickness of all water, oil and gas formations.

OIL, GAS OR WATER RECORDS

CASING RECORD

| FORMATION | CONTENT | FROM | TO | SIZE | PUT IN | PULLED OUT |
|-----------|---------|------|----|--------|--------|------------|
| | | | | 8.5/8" | 794' | None |
| | | | | | | |
| | | | | | | |
| | | | | | | |
| | | | | | | |
| | | | | | | |
| | | | | | | |

Describe in detail the manner in which the well was plugged, indicating where the mud fluid was placed and the method or methods used in introducing it into the hole. If cement or other plugs were used, state the character of same and depth placed, from _____ feet to _____ feet for each plug set.

25 sack plug set at 300'
10 sack plug set at 40'
2 sacks in rat hole

RECEIVED
STATE CORPORATION COMMISSION
MAY 5 1965
5-5-65
CONSERVATION DIVISION
Wichita, Kansas

(If additional description is necessary, use BACK of this sheet)

Name of Plugging Contractor Walters Drilling Co.
Address 510 Orpheum Building, Wichita, Kansas

STATE OF Kansas, COUNTY OF Sedgwick, ss.
W. D. Stancliffe (employee of owner) or (owner or operator) of the above-described well, being first duly sworn on oath, says: That I have knowledge of the facts, statements, and matters herein contained and the log of the above-described well as filed and that the same are true and correct. So help me God.

(Signature) W. D. Stancliffe
W. D. Stancliffe, Ferguson Oil Company
522 Union Center Building, Wichita, Kansas
(Address)

SUBSCRIBED AND SWORN TO before me this 3rd day of May, 1965

My commission expires September 5, 1967

Betty Welch
Betty Welch Notary Public.



ROTARY DRILLING LOG

Operator: Ferguson Oil Company
 No. 1 Werner-Lambert
 (OWWO of No. 1 Werner)
 NE NW SE Sec. 29-30S-14W
 Barber County, Kansas

Contractor: Walters Drilling Co.
 Commenced: April 27, 1965
 Completed: April 30, 1965

Formations

| | |
|---------------------------|------|
| Red Bed | 65 |
| Red Bed & Shells | 700 |
| Anhydrite | 755 |
| Shale & Shells | 1290 |
| Soft Shale & Shells | 1350 |
| Shale, Anhydrite & Shells | 1500 |
| Shale & Shells | 1625 |
| Shale & Lime | 2070 |
| Lime | 2490 |
| Shale & Shells | 2555 |
| Shale & Lime | 2755 |
| Shale & Shells | 2765 |
| Sandy Shale | 3107 |
| Lime | 3775 |
| Shale & Lime | 3939 |
| Lime | 4455 |
| Chert & Lime | 4532 |
| Sand & Lime | 4533 |
| Sand | 4539 |
| Sand & Shale | 4563 |
| Sand | 4573 |
| Sand & Shale | 4644 |
| Chert & Lime | 4665 |
| OTD | 4665 |
| TD | 4550 |

RECEIVED
 STATE CORPORATION COMMISSION
 MAY 5 1965
 5-5-65
 CONSERVATION DIVISION
 Wichita, Kansas

STATE OF Kansas COUNTY OF Sedgwick SS:

I, the undersigned, being duly sworn, on oath state that the above statement and log is a true and correct record and log of the well drilled at the location above described.

FERGUSON OIL COMPANY

By: W. D. Stancliffe
 W. D. Stancliffe

Subscribed and sworn to before me this 4th day of May, 1965.

My Commission Expires Sept. 5, 1967

Betty Welch
 Betty Welch, Notary Public