


STATE OF KANSAS
STATE CORPORATION COMMISSION

Form CP-4

Give All Information Completely
Make Required Affidavit
Mail or Deliver Report to:
Conservation Division
State Corporation Commission
211 No. Broadway
Wichita, Kansas

WELL PLUGGING RECORD

NORTH

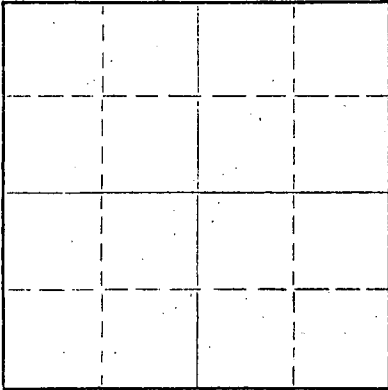Locate well correctly on above
Section Plat

Ness County. Sec. 22 Twp. 20S Rge. 22W (E) (W)

Location as "NE/CNW/SW" or footage from lines C SW SW

Lease Owner Abercombie Drilling, Inc.

Lease Name Tormeey Well No. 1

Office Address 801 Union Center-Wichita, Kansas 67202

Character of Well (completed as Oil, Gas or Dry Hole) Dry Hole

Date well completed 3/13/78 19

Application for plugging filed 3/13/78 19

Application for plugging approved 3/13/78 19

Plugging commenced 3/13/78 19

Plugging completed 3/13/78 19

Reason for abandonment of well or producing formation Dry Hole

If a producing well is abandoned, date of last production 19

Was permission obtained from the Conservation Division or its agents before plugging was commenced? Yes

Name of Conservation Agent who supervised plugging of this well Leo Massey

Producing formation Depth to top Bottom Total Depth of Well 4415 Feet

Show depth and thickness of all water, oil and gas formations.

OIL, GAS OR WATER RECORDS

CASING RECORD

FORMATION	CONTENT	FROM	TO	SIZE	PUT IN	PULLED OUT
	Surface			8 5/8"	359	0

Describe in detail the manner in which the well was plugged, indicating where the mud fluid was placed and the method or methods used in introducing it into the hole. If cement or other plugs were used, state the character of same and depth placed, from feet to feet for each plug set.

1st Plug @ 500' w/50 sx

2nd Plug @ 240' w/25 sx

3rd Plug @ 40' w/10 sx

RECEIVED
STATE CORPORATION COMMISSION

MAR 24 1978

3-24-78

CONSERVATION DIVISION
Wichita, Kansas

(If additional description is necessary, use BACK of this sheet)
Name of Plugging Contractor Thunderbird Drilling, Inc.
Address P. O. Box 18407- Wichita, Kansas 67218

STATE OF KANSAS, COUNTY OF SEDGWICK, ss.
Burke Krueger

(employee of owner) or (owner or operator) of the above-described well, being first duly sworn on oath, says: That I have knowledge of the facts, statements, and matters herein contained and the log of the above-described well as filed and that the same are true and correct. So help me God.

(Signature)


P. O. Box 18407- Wichita, Kansas 67218

(Address)

SUBSCRIBED AND SWORN TO before me this 23rd day of March, 1978

My commission expires 3-25-80

Notary Public.

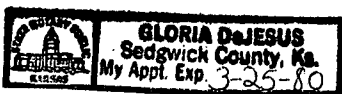

DRILLERS LOG

15135-21432-0000

Company Abercrombie Drilling, Inc.

Contractor Thunderbird Drilling, Inc.

Elevation 2214 K.B.

Farm Tormey

Well No. 1

Casing 8 5/8" 359' w/275 sx

Location C SW SW Sec. 22-20S-22W

County Ness County, Kansas

Production

<u>From</u>	<u>To</u>	<u>Description</u>
0	68	Post Rock
68	300	Shale w/snd strks.
300	359	Red bed & Shale
359	788	Shale & Sand
788	802	Blaine
802	890	Shale
890	1114	Sand
1114	1434	Red Bed & Shale
1434	1483	Anhydrite
1483	2195	Shale & Shells
2195	3855	Lime & Shale
3855	4405	Lime
4405	4415	Lime & Chert
RTD	4415	

RECEIVED
STATE CORPORATION COMMISSION

MAR 24 1978

STATE OF KANSAS)
) ss.
COUNTY OF SEDGWICK)

CONSERVATION DIVISION
Wichita, Kansas

I, Burke Krueger, of Thunderbird Drilling, Inc. upon oath states
that the above and foregoing is a true and correct copy from the Daily Drilling
Report from your #1 Tormey

Burke Krueger

Subscribed and sworn to before me this 23rd day of March, 19 78



Gloria DeJesus
Notary Public

My commission expires: 3-25-80