


STATE OF KANSAS
STATE CORPORATION COMMISSION

Give All Information Completely
Make Required Affidavit
Mail or Deliver Report to:
Conservation Division
State Corporation Commission
211 No. Broadway
Wichita, Kansas

WELL PLUGGING RECORD

NORTH

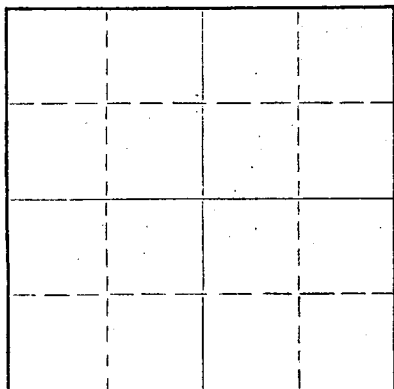

Locate well correctly on above
Section Plat

Barber County. Sec. 11 Twp. 33 Rge. 12 (E) (W)
Location as "NE/CNW/SW" or footage from lines NE NE SW
Lease Owner Honaker-Davis Drlg. Co.
Lease Name Balmer Well No. 1
Office Address 2008 Lakin, Great Bend, Kansas
Character of Well (completed as Oil, Gas or Dry Hole) Dry Hole
Date well completed 6-8 1958
Application for plugging filed 6-7 1958
Application for plugging approved 6-7 1958
Plugging commenced 12:01 A.M. 6-8 1958
Plugging completed 2:00 A.M. 6-8 1958
Reason for abandonment of well or producing formation _____

If a producing well is abandoned, date of last production _____ 19____
Was permission obtained from the Conservation Division or its agents before plugging was commenced? Yes

Name of Conservation Agent who supervised plugging of this well W. L. Lackamp, Stafford, Kansas
Producing formation _____ Depth to top _____ Bottom _____ Total Depth of Well 4802 Feet
Show depth and thickness of all water, oil and gas formations.

OIL, GAS OR WATER RECORDS

CASING RECORD

FORMATION	CONTENT	FROM	TO	SIZE	PUT IN	PULLED OUT
				8 5/8	287	None

Describe in detail the manner in which the well was plugged, indicating where the mud fluid was placed and the method or methods used in introducing it into the hole. If cement or other plugs were used, state the character of same and depth placed, from _____ feet to _____ feet for each plug set.

Filled hole with Heavy rotary mud to 275'. Set Plug. Dumped in 1/3 sack hulls. Mixed 20 sacks cement, put same in through drill pipe.

Filled hole with heavy rotary mud to 35'. Set plug. Dumped in 1/3 sacks hulls. Mixed 15 sacks cement which filled hole to bottom of cellar.

RECEIVED
STATE CORPORATION COMMISSION

JUN 10 1958

CONSERVATION DIVISION
Wichita, Kansas

(If additional description is necessary, use BACK of this sheet)

Name of Plugging Contractor _____
Address _____

STATE OF Kansas, COUNTY OF Barton, ss.
J. T. Bowen (employee of owner) or (~~owner or operator~~) of the above-described well, being first duly sworn on oath, says: That I have knowledge of the facts, statements, and matters herein contained and the log of the above-described well as filed and that the same are true and correct. So help me God.

(Signature)

Great Bend, Kansas
(Address)

SUBSCRIBED AND SWORN to before me this 9th day of June, 1958

My commission expires 6-25-59

Kenneth G. Fischer Notary Public.

PLUGGING
FILE SEC 11 T 32 R 12W
BOOK PAGE 106 LINE 37


DRILLERS' LOG

Balmer No. 1
Loc: NE NE SW
Sec: 11-33S-12W
Barber County, Kansas
Company: Honaker-Davis Drlg. Co., et al
Contractor: Honaker-Davis Drlg. Co.

Comm: 5-24-58
Comp: 6-8-58
Rotary Total Depth: 4802'
Casing: 8 5/8" at 287'
D & A

0	40	Surface Soil	
40	185	Red Bed & Shells	8 5/8" casing cemented at
185	288	Shale & Red Bed	287' with 225 sacks common
288	335	Shale & Shells	cement, 2% Gel and 2%
335	390	Red Bed & Shale	calcium chloride.
390	840	Red Bed, Shale & Gyp	
840	1240	Shale & Shells	
1240	1295	Shale & Gyp	
1295	1330	Anhydrite	
1330	1500	Shale, Shells & Gyp	
1500	1680	Shale, Lime & Shells	
1680	1860	Shale & Lime	
1860	2000	Lime & Shale	
2000	2145	Lime	
2145	2285	Lime & Shale	
2285	2705	Shale & Shells	
2705	3770	Shale & Lime	
3770	4802	Lime	
4802		Total Rotary Depth	D & A

I certify that this is the true and correct copy of the
above log to the best of my knowledge.

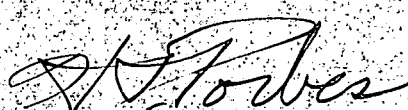
H. S. Forbes.

Subscribed and sworn to before me this 9th day of June, 1958.


Kenneth G. Fischer, Notary Public

My commission expires: 6-25-59

