


WELL PLUGGING RECORD

Give All Information Completely  
Make Required Affidavit  
Mail or Deliver Report to:  
Conservation Division  
State Corporation Commission  
212 North Market, Insurance Bldg.  
Wichita, Kansas

BARBER County. Sec. 19 Twp. 33S Rge. 12W (#) (W)

Location as "NE/CNW/SW" or footage from lines SE SW NE  
Lease Owner PETROLEUM, INC.  
Lease Name COPPINGER Well No. 1  
Office Address ROUTE 2, GREAT BEND, KANSAS  
Character of Well (completed as Oil, Gas or Dry Hole) GAS  
Date well completed 1-23 19 57  
Application for plugging filed 8-14 19 60  
Application for plugging approved 8-14 19 60  
Plugging commenced 8-15 19 60  
Plugging completed 8-19 19 60  
Reason for abandonment of well or producing formation  
DEPLETION OF PRODUCIBLE FORMATION  
If a producing well is abandoned, date of last production JULY 20 19 60  
Was permission obtained from the Conservation Division or its agents before plugging was commenced? YES

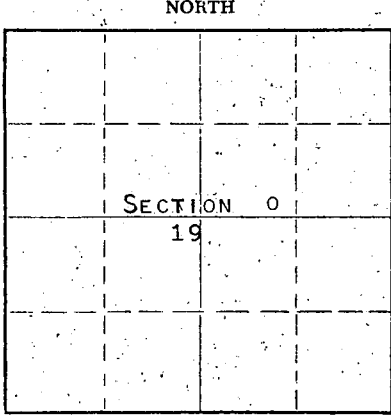

Locate well correctly on above Section Plat

Name of Conservation Agent who supervised plugging of this well FRED W. HAMPEL  
Producing formation MISSISSIPPI Depth to top --- Bottom --- Total Depth of Well 4583 Feet  
Show depth and thickness of all water, oil and gas formations.

OIL, GAS OR WATER RECORDS

CASING RECORD

FORMATION	CONTENT	FROM	TO	SIZE	PUT IN	PULLED OUT
MISSISSIPPI	LITTLE GAS & LITTLE WATER	4464'	4496'	8-5/8"	280'	NONE
				5-1/2"	4580'	3850'

\*Describe in detail the manner in which the well was plugged, indicating where the mud fluid was placed and the method or methods used in introducing it into the hole. If cement or other plugs were used, state the character of same and depth placed, from feet to feet for each plug set.

FILLED HOLE WITH SAND 4583'-4430', PLACED 4 SACKS OF CEMENT ON TOP OF SAND AT 4430'. MUDDERED UP WITH HEAVY MUD TO 220', PLACED SOLID ROCK BRIDGE AT 220' AND PLACED 20 SACKS OF CEMENT ON TOP OF SOLID ROCK BRIDGE. MUDDERED UP WITH HEAVY MUD TO 35' PLACED SOLID ROCK BRIDGE AT 35' AND FILLED HOLE TO BASE OF WELL CELLAR WITH 10 SACKS OF CEMENT

RECEIVED  
STATE CORPORATION COMMISSION  
AUG 26 1960  
CONSERVATION DIVISION  
Wichita, Kansas

(If additional description is necessary, use BACK of this sheet)  
Name of Plugging Contractor MORGAN WELL PLUGGING SERVICE  
Address 102 WEST 18TH STREET, HUTCHINSON, KANSAS

STATE OF KANSAS, COUNTY OF BARTON, ss.  
DON SEARLE (employee of owner) or (owner) the above-described well, being first duly sworn on oath, says: That I have knowledge of the facts, statements, and matters herein contained and the log of the above-described well as filed and that the same are true and correct. So help me God.

(Signature) Don Searle  
ROUTE 2, GREAT BEND, KANSAS  
(Address)

SUBSCRIBED AND SWORN to before me this 25TH day of AUGUST, 19 60

My commission expires NOVEMBER 12, 1962

Brantley  
Notary Public.



# WELL LOG

COMPANY **PETROLEUM, INCORPORATED**

SEC. 19 T. 33S R. 12W

FARM **COPPINGER**

NO. **1**

LOC. **SE, SW, NE**


TOTAL DEPTH **4583'**

COUNTY **Barber Co., Kansas**

COMM. **January 9, 1957**

COMP. **January 23, 1957**

CONTRACTOR **GARVEY DRILLING COMPANY**

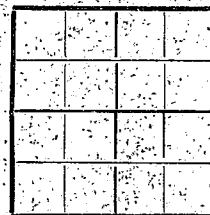

CASING: **8 5/8" @ 280' W/225 sax.**  
**5 1/2" @ 4580' W/100 sax.**

ELEVATION **1516' DF**

PRODUCTION **Mississippian**

FIGURES INDICATE BOTTOM OF FORMATIONS.

40	Surface soil	Elgin	3525'
120	Clay & sand	Heebner	3720
280	Red bed	Douglas	3802
975	Red bed & shale	Lansing	3887
1065	Shale & shells		
1150	Shale & anhydrite strks.		
1370	Shale		
3125	Lime & shale		
3195	Lime		
3330	Lime & shale		
3398	Lime		
3540	Lime & shale		
3675	Shale & sand		
4033	Lime & shale		
4441	Lime		
4508	Lime & chert		
4583	Lime		
4583	T. D.		

**RECEIVED**  
STATE CORPORATION COMMISSION

AUG 26 1960

CONSERVATION DIVISION  
Wichita, Kansas

State of KANSAS

County of BARTON

I, Verne A. Morris of Garvey Drilling Company

upon oath state that the above and foregoing is a true and correct copy of the log of the #1 Coppinger well

*Verne A. Morris*

Subscribed and sworn to before me this 26th day of February 19 57

My Commission Expires: July 11, 1960

*Jed L. Brown*  
NOTARY PUBLIC