

STATE OF KANSAS
STATE CORPORATION COMMISSION


WELL PLUGGING RECORD

OR
FORMATION PLUGGING RECORD

Strike out upper line when reporting plugging off formations.

Give All Information Completely
Make Required Affidavit
Mail or Deliver Report to:
Conservation Division
State Corporation Commission
800 Bitting Building
Wichita, Kansas

Barber County. Sec. 24 Twp. 33S. Rge. 12W (X) (W)
Location as "NE 1/4 NW 1/4 SW 1/4" or footage from lines NE NW NE
Lease Owner Ben F. Brack Oil Company, Inc.
Lease Name J. W. Long Well No. 1
Office Address 309 Brown Building, Wichita, Kansas
Character of Well (completed as Oil, Gas or Dry Hole) Dry Hole
Date well completed 6-15-54 19
Application for plugging filed 6-15-54 19
Application for plugging approved 6-15-54 19
Plugging commenced 6-15-54 19
Plugging completed 6-15-54 19
Reason for abandonment of well or producing formation Dry hole

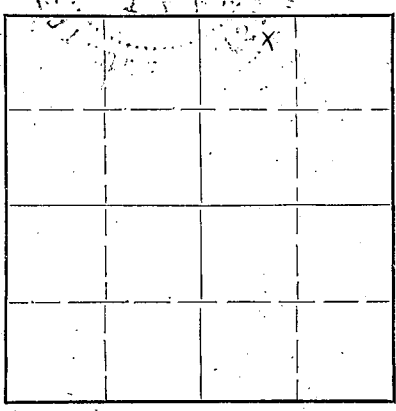

Locate well correctly on above Section Plat

Name of Conservation Agent who supervised plugging of this well Merle Rives
Producing formation Douglas Sand Depth to top 3730' Bottom 3750' Total Depth of Well 3750 Feet
Show depth and thickness of all water, oil and gas formations.

OIL, GAS OR WATER RECORDS

CASING RECORD

Formation	Content	From	To	Size	Put In	Pulled Out
Surface - Red Bed, Shale & Shells		0	196	8 5/8	193	None
Red Bed, Shale, Shells, Anhydrite, Lime		196	3730			
Douglas Sand		3730	3750			

Describe in detail the manner in which the well was plugged, indicating where the mud fluid was placed and the method or methods used in introducing it into the hole. If cement or other plugs were used, state the character of same and depth placed, from 190' feet to 35' feet for each plug set.

Filled hole with heavy mud to 190'. Set a Halliburton plug at 190' and cemented with 20 sax cement. Set a Halliburton plug at 35' and cemented with 10 sax cement. Leveled location.

RECEIVED
STATE CORPORATION COMMISSION
JUN 19 1954
CONSERVATION DIVISION
Wichita, Kansas


(If additional description is necessary, use BACK of this sheet)

Correspondence regarding this well should be addressed to Ben F. Brack Oil Company, Inc.
Address 309 Brown Building, Wichita 2, Kansas

STATE OF KANSAS, COUNTY OF SEDGWICK, ss.
BERNARD D. GRANT (employee of owner) or ~~owner~~ of the above-described well,
being first duly sworn on oath, says: That I have knowledge of the facts, statements, and matters herein contained and the log of the above-described well as filed and that the same are true and correct. So help me God.

(Signature) Bernard D. Grant
309 Brown Bldg., Wichita 2, Kansas
(Address)

SUBSCRIBED AND SWORN to before me this 17th day of June, 1954.
June 11, 1955.
Notary Public.

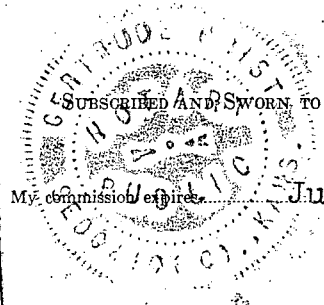

PLUGGING
FEEL SEC 24 T 33 R 12W
BOOK PAGE 41 LINE 29

BILL P. BRACK OIL COMPANY, INC.
 309-10 BROWN BUILDING
 WICHITA 2, KANSAS

J. W. LONG #1

521 111 112

Sec. 24-31N-12W
 Barber County, Kansas
 CORNERED: 8-1-54
 COMPLETED: 6-15-54

TOTAL DEPTH 3710'
 ELEVATION: 1428' MS
 1426' GS.

FORMATION

Red Bed	0 -	75'
Shale & Shells		196
Red Bed		230
Red Bed & Shale		1130
Shale & Shells		1130
Anhydrite		1245
Shale & Linc		1490
Linc		1735
Linc & Shale		1900
Linc		1975
Linc & Shale		2275
Shale & Linc		2455
Linc & Shale		2660
Shale & Linc		2815
Linc & Shale		3015
Linc		3230
Linc & Shale		3365
Shale & Linc		3434
Linc & Shale		3510
Shale & Linc		3650
Linc & Shale		3710
Shale & Linc		3750 S.S. D.A.A.

The above depths denote bottom of formations.

LOGGING

8 5/8"

193'

To the best of my knowledge, the above is a true and correct account of the depths and formations and those found.

BILL P. BRACK OIL COMPANY, INC.

By

Bernard D. Grant

WITNESSED

W. Strada Crest

June 17, 1954.

PLUGGING

WELL NO. 24133-12W
 BOOK PAGE 44 LINE 29

RECEIVED
 STATE CORPORATION COMMISSION
 JUN 19 1954
 CONSERVATION DIVISION
 Wichita, Kansas