

STATE OF KANSAS
STATE CORPORATION COMMISSION

Give All Information Completely
Make Required Affidavit
Mail or Deliver Report to:
Conservation Division
State Corporation Commission,
800 Bittling Building
Wichita, Kansas


WELL PLUGGING RECORD

OR

FORMATION PLUGGING RECORD

Strike out upper line
when reporting plug-
ging off formations.

NORTH

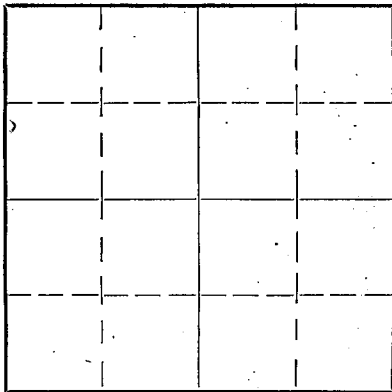

Locate well correctly on above
Section Plat

RUSH

County. Sec. 19 Twp. 19 Rge. (E) 16 (W)

Location as "NE $\frac{1}{4}$ NW $\frac{1}{4}$ SW $\frac{1}{4}$ " or footage from lines NW cor. NE $\frac{1}{4}$

Lease Owner WESTGATE-GREENLAND OIL COMPANY

Lease Name GREENAWALT Well No. 1

Office Address 4706 Broadway - KANSAS CITY, MO.

Character of Well (Completed as Oil, Gas or Dry Hole) Dry Hole

Date, well completed JUNE 23 1937

Application for plugging filed JUNE 11 1937

Application for plugging approved JUNE 11 1937

Plugging Commenced JUNE 24 1937

Plugging Completed JUNE 25 1937

Reason for abandonment of well or producing formation

HOLE FULL OF WATER

If a producing well is abandoned, date of last production 1937

Was permission obtained from the Conservation Division or its agents before plugging was commenced?

YES

Name of Conservation Agent who supervised plugging of this well ALEXANDER

Producing formation Depth to top Bottom Total Depth of Well 4014 Feet

Show depth and thickness of all water, oil and gas formations.

OIL, GAS OR WATER RECORDS

CASING RECORD

Formation	Content	From	To	Size	Put In	Pulled Out
				15 $\frac{1}{2}$	100'	Left in Hole
				Cemented from		top to bottom
				10 $\frac{1}{2}$	1030'	Left in Hole
				Cemented from		top to bottom
				7" OD	3879'	Pulled 1950'


Describe in detail the manner in which the well was plugged, indicating where the mud fluid was placed and the method or methods used in introducing it into the hole. If cement or other plugs were used, state the character of same and depth placed, from feet to feet for each plug set.

FILLED WITH MUD TO 3750' CEMENT PLUG 3750' to 3708'

FILLED WITH MUD 3708' to 300' CEMENT PLUG 15 SACKS OF

CEMENT AT 300' MUD 300' TO SURFACE 5 SACKS CEMENT AT

SURFACE

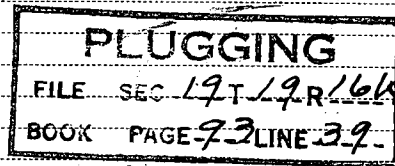

(If additional description is necessary use BACK of this sheet)

Correspondence regarding this well should be addressed to A. H. PARKS

Address BOX 63 - HUTCHINSON, KANSAS

STATE OF KANSAS, COUNTY OF RENO, ss.

C. C. NELSON (employee of owner) or (owner or operator) of the above-described well, being first duly sworn on oath, says: That I have knowledge of the facts, statements, and matters herein contained and the log of the above-described well as filed and that the same are true and correct. So help me God.

(Signature)

Nelson Dailing
C. C. Nelson

(Address)

SUBSCRIBED AND SWORN to before me this 1st day of JULY, 1937.

My commission expires

Dec 5, 1939

Notary Public

WELL LOG

WESTGATE-GREENLAND OIL COMPANY
NO. 1 GREENAWALTLOCATION: NW cor. NE $\frac{1}{4}$ Sec. 19W
19-16 RUSH COUNTYCasing Record: 15 $\frac{1}{2}$ " 100'
10 $\frac{1}{2}$ " 1030'
7" 3879'

10	Cellar	2448	Red Rock
15	Shale	2465	Lime
20	Sand	2479	Shale & Lime
40	Shale	2489	Lime
50	Lime Shell	2496	Slate
95	Shale	2520	Lime
220	Shale & Lime	2560	Shale & Shells
285	Sand Rock	2572	Brown Lime
452	Lime Shell	2610	Lime & Shale
457	Shale	2615	Lime
465	Hard Shell	2647	Blue Shale
495	Blue Shale	2652	Red Shale
502	Hard Sand	2662	Shale & Lime Shells
509	Soft Sand	2680	Broken Lime
538	Lime	2693	Lime
596	Shale & Shell	2703	Shale & Shells
600	Shale	2733	Shale & Lime Shells
705	Gray Sand	2740	Shale
750	Red Sandy Shale	2750	Lime
775	Blue Shale	2765	Slate
896	Red Shale	2775	Lime
915	Red Shale	2782	Slate
939	Blue Shale	2823	Shale
977	Red Shale	2866	Shale & Shells
1050	Slate	2940	Blue Slate
1215	Red Shale	2975	Lime
1220	Gyp	2995	Shale
1245	Anhydrite	3015	Lime
1255	Blue Shale	3030	Lime & Shells
1415	Red Shale	3040	Sticky Shale
1445	Blue Shale	3060	Lime
1468	Gray Shale	3080	Shale & Shells
1500	Blue Shale & Lime Shells	3104	Lime
1530	Red & Blue Shale	3137	Soft Lime
1540	Shells	3146	Shale
1640	Blue Shale	3205	Lime
1660	Sticky Shale	3216	Shale
1705	Shale & Gyp	3250	Lime
1800	Broken Lime Shells	3255	Shale
1840	Shale & Gyp	3400	Lime
1925	Shells & Gyp	3413	Sandy Lime
1960	Shale & Gyp	3465	Shale & Lime
2035	Slate & Lime	3485	Lime
2100	Gray Lime	3490	Lime & Shale
2145	Sandy Lime	3515	Lime
2160	Lime	3537	Shale & Lime
2175	Blue Slate	3549	Hard Lime
2190	Soft Blue Shale	3554	Sandy Lime
2200	Red Shale	3565	Hard Lime
2210	Sandy Lime	3570	Sandy Lime
2229	Hard Blue Shale	3575	Lime
2235	Sandy Shale	3596	Sandy Lime
2265	Gray Sandy Lime	3600	Gray Lime
2290	Sandy Lime & Shale	3605	Broken Lime
2296	Sticky Shale	3613	Lime
2305	Sticky Shale	3630	Hard Lime
2320	Gray Lime	3647	Soft Sandy Lime
2330	Shale	3658	Lime
2346	Lime	3700	Lime
2385	Blue Shale & Lime	3710	Red Shale & Lime
2395	Sticky Shale	3723	Shells
2405	Hard Gray Lime	3760	Brown Lime
2425	Blue Shale	3807	Lime Shells
2430	Lime	3825	Lime
2445	Shale & Lime Shells		Blue Shale

PLUGGING

FILE SEC 19-T-19-R-164
BOOK PAGE 93 LINE 39

WESTGATE-GREENLAND OIL CO.
1 GREENAWALT 19-19-16 RUSH COUNTY

3832 Conglomerate Shale (Run Core Barrel)
3845 Variegated Shale
3860 Conglomerate
3874 Blue Shale
3884 Shale 2ft- Siliceous Lime - 2ft.
Show of Oil

3879 Set 7" OD Pipe
Cemented 100 sacks
3919 Siliceous Lime (Standard Tools)
(Show of Oil)
3920 3 Bailers of Water
4017 Siliceous Lime
Hole Full of Sulphur Water

STATE OF KANSAS)
COUNTY OF RENO) SS

C. C. Nelson, Drilling Contractor of the above described well being first duly sworn on oath, says: That I have knowledge of the facts, statements, and matters herein contained and the log of the above described well as filed and that the same are true and correct.
So help me God.

Nelson Drilling Co
Cy C Nelson

Subscribed and Sworn to before me the 1st day of July, 1937

Cliff Kehn
Notary Public

My Commission Expires

December 5, 1939

