

Give All Information Completely  
Make Required Affidavit  
Mail or Deliver Report to:  
Conservation Division  
State Corporation Commission  
212 No. Market  
Wichita, Kansas

WELL PLUGGING RECORD

Rush County. Sec. 29 Twp. 19S Rge. 16W (E) (W)

Location as "NE/CNW/SW" or footage from lines SW SW NW

Lease Owner Martin & Keller

Lease Name Hagerman Well No. 1

Office Address 1035 Kennedy Bldg., Tulsa, Okla.

Character of Well (completed as Oil, Gas or Dry Hole) Dry Hole

Date well completed 6-10-66 19

Application for plugging filed 6-10-66 19

Application for plugging approved 6-10-66 19


Plugging commenced 6-10-66 19

Plugging completed 6-10-66 19

Reason for abandonment of well or producing formation Dry Hole

If a producing well is abandoned, date of last production \_\_\_\_\_ 19

Was permission obtained from the Conservation Division or its agents before plugging was commenced? yes

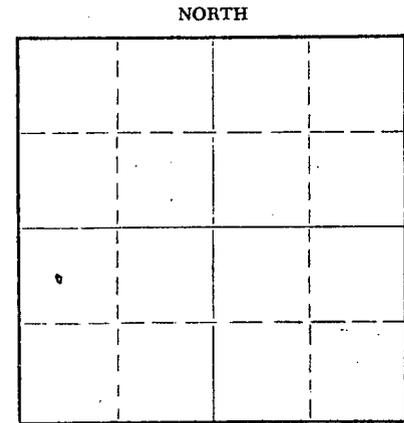

Locate well correctly on above  
Section Plat

Name of Conservation Agent who supervised plugging of this well Leo Massey, Hays, Kansas

Producing formation \_\_\_\_\_ Depth to top \_\_\_\_\_ Bottom \_\_\_\_\_ Total Depth of Well 3881' Feet

Show depth and thickness of all water, oil and gas formations.

OIL, GAS OR WATER RECORDS

CASING RECORD

FORMATION	CONTENT	FROM	TO	SIZE	PUT IN	PULLED OUT
				8 5/8"	255.50'	none

Describe in detail the manner in which the well was plugged, indicating where the mud fluid was placed and the method or methods used in introducing it into the hole. If cement or other plugs were used, state the character of same and depth placed, from \_\_\_\_\_ feet to \_\_\_\_\_ feet for each plug set.

Displaced 25 sacks cement through drill pipe @ 420'  
Displaced 20 sacks cement through drill pipe @ 250'  
Plug Set @ 40' w/10 sks. cement

RECEIVED  
STATE CORPORATION COMMISSION  
JUN 14 1966  
6-14-66  
CONSERVATION DIVISION  
Wichita, Kansas

(If additional description is necessary, use BACK of this sheet)

Name of Plugging Contractor Leben Drilling, Inc.

Address Box 486, Great Bend, Kansas 67530

STATE OF KANSAS, COUNTY OF BARTON, ss.

Leslie Kite (employee of owner) or (owner or operator) of the above-described well, being first duly sworn on oath, says: That I have knowledge of the facts, statements, and matters herein contained and the log of the above-described well as filed and that the same are true and correct. So help me God.

(Signature) Leslie Kite

P. O. Box 486, Great Bend, Kansas 67530  
(Address)

SUBSCRIBED AND SWORN TO before me this 13th day of June, 19 66

My commission expires April 1, 1967

Ulanda Nichols  
Notary Public.

DRELLER'S LOG

COMPANY: Martin & Keller  
 CONTRACTOR: LEBEN DRILLING, INC.  
 FARM: HAGERMAN #1  
 LOCATION: SW SW NW Sec. 29-19S-16W  
 RUSH COUNTY, KANSAS  
 COMMENCED: 6-3-66  
 COMPLETED: 6-10-66

0	110	Shale, Sand, Native Rock
110	555	Shale
555	700	Dakota Sand
700	1174	Shale, Shells
1174	1205	Anhydrite
1205	1860	Shale, Shells
1860	2322	Shale, Lime
2322	3410	Lime, Shale
3410	3881	Lime
	<u>3881</u>	<u>RTD - D. &amp; A.</u>

RECEIVED  
 STATE CORPORATION COMMISSION  
 JUN 14 1966  
 6-14-66  
 CONSERVATION DIVISION  
 WICHITA, KANSAS

8 5/8" used surface casing Set @ 255.50' cemented with 175 sacks  
 Common cement, 2% cc

I, Leslie Kite, do hereby certify that the above and foregoing is  
 a true and correct copy of the log of the Hagerman #1 well, located  
 SW SW NW of Section 29, Township 19 South, Range 16 West, Rush County,  
 Kansas, as reflected by the records of Leben Drilling, Inc.

*Leslie Kite*  
 Leslie Kite

STATE OF KANSAS )  
 ) SS  
 COUNTY OF BARTON)

Subscribed and sworn to and before me, a Notary Public, in  
 and for Barton County, Kansas, this 13th day of June, 1966.

*Ulanda Nichols*  
 Ulanda Nichols

My Commission Expires:  
 April 1, 1967