

15-16-00100-0000

STATE OF KANSAS
STATE CORPORATION COMMISSION

WELL PLUGGING RECORD

Give All Information Completely
Make Required Affidavit
Mail or Deliver Report to:
Conservation Division
State Corporation Commission
800 Bittling Building
Wichita, Kansas

OR
FORMATION PLUGGING RECORD

Strike out upper line
when reporting plug-
ging off formations.

R Rush County. Sec. 29 Twp. 19 Rge. 16 (E) (W)

Location as "NE $\frac{1}{4}$ NW $\frac{1}{4}$ SW $\frac{1}{4}$ " or footage from lines SE NE NE

Lease Owner Iron Drilling Company

Lease Name Austermiller Well No. 1

Office Address 1206 Philtower Building, Tulsa, Oklahoma.

Character of Well (completed as Oil, Gas or Dry Hole) Dry Hole

Date well completed Sept. 8, 1951 19

Application for plugging filed Sept. 8, 1951 19

Application for plugging approved Do. 19


Plugging commenced Do. 19

Plugging completed Do. 19

Reason for abandonment of well or producing formation Dry Hole

If a producing well is abandoned, date of last production 19

Was permission obtained from the Conservation Division or its agents before plugging was com-
menced? Yes

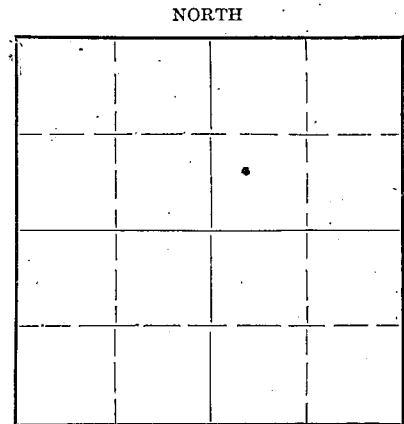

Locate well correctly on above
Section Plat

Name of Conservation Agent who supervised plugging of this well C. D. Stough

Producing formation Depth to top Bottom Total Depth of Well Feet

Show depth and thickness of all water, oil and gas formations.

OIL, GAS OR WATER RECORDS

CASING RECORD

| Formation | Content | From | To | Size | Put In | Pulled Out |
|-----------|---------|------|----|-------|--------|------------|
| Arbuckle | Water | | | 8-5/8 | 1031 | None |
| | | | | | | |
| | | | | | | |
| | | | | | | |
| | | | | | | |
| | | | | | | |
| | | | | | | |

Describe in detail the manner in which the well was plugged, indicating where the mud fluid was placed and the method or methods used in introducing it into the hole. If cement or other plugs were used, state the character of same and depth placed, from feet to feet for each plug set.

Hole filled with heavy mud.
Bottom Plug set at 270 feet cemented with 15 sacks of cement
Top Plug set at 30 feet cemented with 15 sacks of cement

(If additional description is necessary, use BACK of this sheet)
Correspondence regarding this well should be addressed to Iron Drilling Co.
1206 Philtower Building, Tulsa, Oklahoma.
Address

STATE OF Okla., COUNTY OF Tulsa, ss.
J. L. Stackpole (employee of owner) or (owner or operator) of the above-described well,

being first duly sworn on oath, says: That I have knowledge of the facts, statements, and matters herein contained and the log of the above-described well as filed and that the same are true and correct. So help me God.

(Signature) J. L. Stackpole
1206 Philtower Building, Tulsa, Okla.
SEP 20 1951
Conservation Division
Wichita, Kansas
9-29-51

SUBSCRIBED AND SWORN to before me this 27th day of September, 1951

My commission expires Feb. 28, 1952 Notary Public.

22-2625 2-48-15M

PLUGGING
FILE SEC 29 T 19 R 16
BOOK PAGE 108 LINE 45

DRILLING RECORD

Austermiller Well #1
 SE NE NE Section 29-19-16W
 Rush County, Kansas

Casing Record

1031' - 8-5/8" Casing (Surface)
 Cemented w/ 450 sacks of cement

Work Commenced August 24, 1951
 Drilling Commenced August 25, 1951
 Drilling Completed Sept. 8, 1951
 Work Completed Sept. 8, 1951

No Oil String - Dry Hole.

Well Log

| | | |
|------------------------|------|---------|
| Shale | 0 | 775 |
| Red Bed | 775 | 954 |
| Red Bed & Sand | 954 | 1031 |
| Red Bed | 1031 | 1160 |
| Anhydrite | 1160 | 1220 |
| Red Bed Shale & Shells | 1220 | 1855 |
| Lime & Shale | 1855 | 2845 |
| Sand & Shale | 2845 | 2975 |
| Lime | 2975 | 3045 |
| Lime & Shale | 3045 | 3110 |
| Lime | 3110 | 3287 |
| Lime & Chert | 3287 | 3325 |
| Lime Chert & Shale | 3325 | 3397 |
| Lime | 3397 | 3575 |
| Lime & Shale | 3575 | 3622 |
| Lime | 3622 | 3719 |
| Lime & Shale | 3719 | 3767 |
| Lime | 3767 | 3876 TD |

RECEIVED
 STATE COMMISSION
 SEP 27 5 1951
 CONSERVATION DIVISION
 WICHITA, KANSAS

PLUGGING
 FILE SEC 29-19-16W
 COOK PAGE 108 LINE 45