


STATE OF KANSAS
STATE CORPORATION COMMISSION

WELL PLUGGING RECORD

Give All Information Completely
Make Required Affidavit
Mail or Deliver Report to:
Conservation Division
State Corporation Commission
211 No. Broadway
Wichita, Kansas

Barber County, Sec. 36 Twp. 33S Rge. 12 (W)

Location as "NE/CNW/SW" or footage from lines C NE SE NE
Lease Owner Gulf Oil Corporation
Lease Name F. E. Fitzgerald Well No. 1
Office Address Box 661, Tulsa, Oklahoma
Character of Well (completed as Oil, Gas or Dry Hole) Dry Hole
Date well completed 6-26 1958
Application for plugging filed 6-26- 1958
Application for plugging approved (Verbally 6-26-58) 6-30 1958
Plugging commenced 6-26 1958
Plugging completed 6-26 1958
Reason for abandonment of well or producing formation Dry Hole

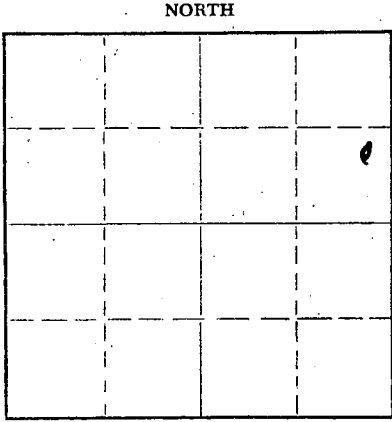

Locate well correctly on above Section Plat

If a producing well is abandoned, date of last production - - - 19 -
Was permission obtained from the Conservation Division or its agents before plugging was commenced? Yes

Name of Conservation Agent who supervised plugging of this well W. L. Lackamp
Producing formation - - - Depth to top - - - Bottom - - - Total Depth of Well 4650' Feet
Show depth and thickness of all water, oil and gas formations.

OIL, GAS OR WATER RECORDS

CASING RECORD

FORMATION	CONTENT	FROM	TO	SIZE	PUT IN	PULLED OUT
				8-5/8"	267'	0

Describe in detail the manner in which the well was plugged, indicating where the mud fluid was placed and the method or methods used in introducing it into the hole. If cement or other plugs were used, state the character of same and depth placed, from _____ feet to _____ feet for each plug set.
Mudded hole to 260', placed HOWCO plug at 260' with 2 sx. hulls on top, then spotted 20 sx. cement thru drill pipe. Filled with mud to 45', set HOWCO plug with 2 sx. hulls, then cemented to base of cellar with 15 sx. cement.


NOTE: Attached is driller's formation record which was not available at time application was filed.

(If additional description is necessary, use BACK of this sheet)
Name of Plugging Contractor Gabbert-Jones Drilling Company
Address Wichita, Kansas

STATE OF Kansas, COUNTY OF Sedgwick, ss.
Thomas A. Trax (employee of owner) or (owner or operator) of the above-described well, being first duly sworn on oath, says: That I have knowledge of the facts, statements, and matters herein contained and the log of the above-described well as filed and that the same are true and correct. So help me God.

(Signature) *Thomas A. Trax*
Box 2233, Wichita, Kansas (Address)

SUBSCRIBED AND SWORN TO before me this 8th day of July, 1958
My commission expires 9-7-61
J.W. Garner Notary Public

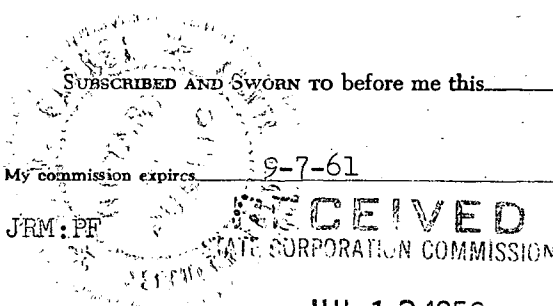

PLUGGING
FILE SEC 36 T 33 R 12u
BOOK PAGE 111 LINE 12

CONSERVATION DIVISION
Wichita, Kansas

GABBERT-JONES DRILLING CO., INC.

WICHITA, KANSAS

DRILLER'S WELL LOG

F. E. FITZGERALD #1
 NE SE NE SECTION 36-33S-12W
 BARBER COUNTY, KANSAS
 COMMENCED 6-12-58
 COMPLETED 6-26-58

DEPTH		FORMATION	REMARKS
FROM	TO		
0	270	RED BED & GYP	RAN 270' OF 8-5/8" CASING, CEMENTED WITH 250 BAGS CEMENT.
270	400	RED BED	
400	1380	RED BED, SHALE & LIME	
1380	1592	SHALE	
1592	1761	ANHYDRITE	
1761	1900	LIME	
1900	2200	LIME & SHALE	
2200	2295	SHALE	
2295	3915	LIME & SHALE	
3915	4010	LIME	
4010	4275	LIME & SHALE	
4275	4375	LIME	
4375	4615	LIME & SHALE	
4615	4650	LIME	
4650		TD	DRY AND ABANDONED

I, E. E. HALL, CERTIFY THIS TO BE A TRUE AND CORRECT COPY OF THE DRILLER'S WELL LOG FOR THE F. E. FITZGERALD #1.

E. E. Hall

 E. E. HALL

STATE OF KANSAS)
) SS:
 COUNTY OF SEDGWICK)

BEFORE ME, THE UNDERSIGNED, A NOTARY PUBLIC, WITHIN AND FOR SAID COUNTY AND STATE, ON THIS 27TH DAY OF JUNE, 1955 PERSONALLY APPEARED E. E. HALL TO ME PERSONALLY KNOWN TO BE THE IDENTICAL PERSON WHO EXECUTED THE WITHIN AND FOREGOING INSTRUMENT AND ACKNOWLEDGED TO ME THAT HE EXECUTED THE SAME AS HIS FREE AND VOLUNTARY ACT AND DEED FOR THE USES AND PURPOSES THEREIN SET FORTH.

IN WITNESS WHEREOF, I HAVE HEREUNTO SET MY HAND AND OFFICIAL SEAL THE DAY AND YEAR LAST ABOVE WRITTEN.

Luc N. Arnold

 NOTARY PUBLIC

MY COMMISSION EXPIRES NOVEMBER 9, 1959.

STATE OF KANSAS
 STATE CORPORATION COMMISSION
 JUL 12 1958
 CONSERVATION DIVISION
 WICHITA, KANSAS

PLUGGING
 FILE SEC 36 T 33 R 12W
 BOOK PAGE 111 LL 12