


STATE OF KANSAS
 STATE CORPORATION COMMISSION
 CONSERVATION DIVISION
 P. O. BOX 17027
 WICHITA, KANSAS 67217

FORM CP-4

WELL PLUGGING RECORD

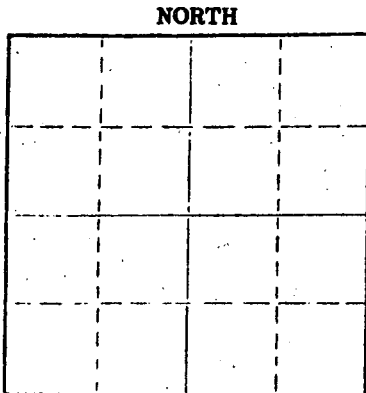

Locate well correctly on above Section Plat

Barber County. Sec 36 Twp 33 Rge (E) 12 (W)
 Location as "NE/CNW&SW&" or footage from lines C SE SE
 Lease Owner SANDS DRILLING COMPANY
 Lease Name Nurse=Bevans Well No 1
 Office Address 912 Philtower Bldg., Tulsa, Okla. 74103
 Character of Well (completed as Oil, Gas or Dry Hole) Dry Hole
 Date well completed 1-22 19 76
 Application for plugging filed 1-22 19 76
 Application for plugging approved 1-22 19 76
 Plugging commenced 1-22 19 76
 Plugging completed 1-22 19 76
 Reason for abandonment of well or producing formation No commercial quantities of oil or gas encountered.
 If a producing well is abandoned, date of last production 19
 Was permission obtained from the Conservation Division or its agents before plugging was commenced? Yes

Name of Conservation Agent who supervised plugging of this well G.R. Biberstein
 Producing formation Depth to top Bottom Total Depth of Well 4763 Feet
 Show depth and thickness of all water, oil and gas formations.

OIL, GAS OR WATER RECORDS

CASING RECORD

| FORMATION | CONTENT | FROM | TO | SIZE | PUT IN | PULLED OUT |
|--------------|---------|------|-----|--------|--------|------------|
| Surface Hole | Water | Surf | 207 | 8-5/8" | 199' | None |
| | | | | | | |
| | | | | | | |
| | | | | | | |

Describe in detail the manner in which the well was plugged, indicating where the mud fluid was placed and the method or methods used in introducing it into the hole. If cement or other plugs were used, state the character of same and depth placed, from feet to feet for each plug set.

Fluid to 257', plug, 50 sx cement;
 Fluid to 45', plug, 15 sx cement;
~~xxxx~~ Ten sacks in rat hole.

RECEIVED
 STATE CORPORATION COMMISSION

JAN 30 1976

CONSERVATION DIVISION
 Wichita, Kansas

(If additional description is necessary, use BACK of this sheet)
 Name of Plugging Contractor D N B DRILLING, INC.
 Address 701 First National Building
 Wichita, Kansas 67202

STATE OF KANSAS COUNTY OF ss.
 JAMES L. DONELSON

(employee of owner) or (owner or operator) of the above-described well, being first duly sworn on oath, says: That I have knowledge of the facts, statements, and matters herein contained and the log of the above-described well as filed and that the same are true and correct. So help me God.

(Signature) James L. Donelson
 701 First Nat'l Bldg., Wichita, Ks.
 (Address)

SUBSCRIBED AND SWORN TO before me this 28th day of January 19 76

My commission expires 8-25-76

Ella Priess
 Notary Public.

Ella Priess
 STATE NOTARY PUBLIC
 Sedgwick County, Kansas
 My Com. Expires Aug. 25, 1976

DRILLERS' LOG

SANDS DRILLING COMPANY
No. 1 Nurse-Bevans
C SE SE, Sec. 36-33S-12W
Barber County, Kansas

Commenced: 1-13-76
Completed: 1-22-76

Surface Casing: 199' of
8-5/8" cemented w/170 sx
common cement, 2% cc.
1-14-76

| <u>FORMATION</u> | <u>DEPTH</u> |
|------------------|-----------------|
| Red Bed | 0 - 180 |
| Shale & Sand | 180 - 800 |
| Shale & Lime | 800 - 2345 |
| Lime & Shale | 2345 - 2810 |
| Shale & Lime | 2810 - 3000 |
| Lime & Shale | 3000 - 3505 |
| Shale & Lime | 3505 - 3730 |
| Lime & Shale | 3730 - 3940 |
| Lime | 3940 - 4110 |
| Lime & Shale | 4110 - 4270 |
| Lime | 4270 - 4585 |
| Cherty Lime | 4585 - 4663 |
| Lime | 4663 - 4763 RTD |

I do hereby certify that the foregoing statements are true and correct to the best of my knowledge and belief.

D. N. B. DRILLING, INC.

James L. Donelson
JAMES L. DONELSON

RECEIVED
STATE CORPORATION COMMISSION

JAN 30 1976

STATE OF KANSAS: ss:

CONSERVATION DIVISION
Wichita, Kansas

Subscribed and sworn to before me this 28th day of January, 1976.

Ella Priess
Ella Priess, Notary Public

Ella Priess
STATE NOTARY PUBLIC
Sedgwick County, Kansas
My Com. Expires Aug. 25, 1976

Ella Priess
STATE NOTARY PUBLIC
Sedgwick County, Kansas
My Com. Expires Aug. 25, 1976

KANSAS DRILLERS LOG

S. 36 T. 33 R. 12 ^R/_W
 Loc. 660' FSL & 660' FEL
 County Barber

API No: 15 — 007 — 20,379
 County Number

Operator
Sands Drilling Company

Address
912 Philtower Building, Tulsa, Oklahoma 74103


Well No. #1 Lease Name Nurse Bevans

Footage Location
660' feet from (X) (S) line 660' feet from (E) (W) line

Principal Contractor DNB Drilling Geologist Bob Sandridge

Spud Date 1-13-76 Total Depth 4763' P.B.T.D.

Date Completed 1-23-76 Oil Purchaser

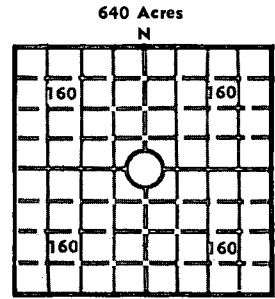

Elev.: Gr. _____
 DF _____ KB _____

CASING RECORD

Report of all strings set — surface, intermediate, production, etc.

| Purpose of string | Size hole drilled | Size casing set (in O.D.) | Weight lbs/ft. | Setting depth | Type cement | Sacks | Type and percent additives |
|-------------------|-------------------|---------------------------|----------------|--|-------------|-------|----------------------------|
| Surface | 12-1/4 | 8-5/8 | 28.8 | 1207' | regular | 170 | 3% CC |
| | | | | JAN 28 1976 | | | |
| | | | | CONSERVATION DIVISION Wichita, Kansas | | | |

LINER RECORD

PERFORATION RECORD

| Top, ft. | Bottom, ft. | Sacks cement | Shots per ft. | Size & type | Depth interval |
|----------|-------------|--------------|---------------|-------------|----------------|
| | | | | | |

| Size | Setting depth | Packer set at |
|------|---------------|---------------|
| | | |

ACID, FRACTURE, SHOT, CEMENT SQUEEZE RECORD

| Amount and kind of material used | Depth interval treated |
|---|------------------------|
| Plugged as follows: 50 sk plug 257'-152'. 15 sk plug 45'-0' | |
| 5' sk plug in rat hole & mouse hole. | |

INITIAL PRODUCTION

| | |
|--|--|
| Date of first production <u>dry hole</u> | Producing method (flowing, pumping, gas lift, etc.) |
| RATE OF PRODUCTION PER 24 HOURS | Oil _____ bbls. Gas _____ MCF Water _____ bbls. Gas-oil ratio _____ CFPB |
| Disposition of gas (vented, used on lease or sold) | Producing interval(s) |

INSTRUCTIONS: As provided in KCC Rule 82-2-125, within 90 days after completion of a well, one completed copy of this Drillers Log shall be transmitted to the State Geological Survey of Kansas, 4150 Monroe Street, Wichita, Kansas 67209. Copies of this form are available from the Conservation Division, State Corporation Commission, 3830 So. Meridian (P.O. Box 17027), Wichita, Kansas 66217. Phone AC 316-522-2206. If confidential custody is desired, please note Rule 82-2-125. Drillers Logs will be on open file in the Oil and Gas Division, State Geological Survey of Kansas, Lawrence, Kansas 66044.

Operator
Sands Drilling Co.

DESIGNATE TYPE OF COMP.: OIL, GAS,
DRY HOLE, SWDW, ETC.:
dry hole

Well No. 1 Lease Name Nurse Bevans

S 36 T 33S R 12 W

WELL LOG

Show all important zones of porosity and contents thereof; cored intervals, and all drill-stem tests, including depth-interval tested, cushion used, time tool open, flowing and shut-in pressures, and recoveries.

SHOW GEOLOGICAL MARKERS, LOGS RUN, OR OTHER DESCRIPTIVE INFORMATION.

| FORMATION DESCRIPTION, CONTENTS, ETC. | TOP | BOTTOM | NAME | DEPTH |
|---------------------------------------|-----|--------|------|-------|
| DST #1 4586-4642' | | | | |
| Open 30 minutes | | | | |
| SI 60 minutes | | | | |
| Open 90 minutes | | | | |
| SI 120 minutes | | | | |
| 4759' IH 2407 | | | | |
| IF 8-8 | | | | |
| ISI 16 | | | | |
| FF 8-8 | | | | |
| FSI 16 | | | | |
| FH 2391 | | | | |
| 4576' IH 2528 | | | | |
| IF 34-34 | | | | |
| ISI 43 | | | | |
| FF 34-34 | | | | |
| FSI 4310 | | | | |
| FH 2510 | | | | |
| BHT 115° | | | | |

USE ADDITIONAL SHEETS, IF NECESSARY, TO COMPLETE WELL RECORD.

Date Received

Bobby Young
Signature
Manager Drilling & Production
Title
January 26, 1976
Date