

STATE OF KANSAS
STATE CORPORATION COMMISSION

Form CP-4


Give All Information Completely
Make Required Affidavit
Mail or Deliver Report to:
Conservation Division
State Corporation Commission
212 No. Market
Wichita, Kansas

WELL PLUGGING RECORD

Barber County, Sec. 34 Twp. 33 Rge. 12 (E) (W)

Location as "NE/CNW%SW%" or footage from lines CE/2 NE SE
Lease Owner Bowers Drilling Company
Lease Name Wright Well No. 1
Office Address Wichita, Kansas
Character of Well (completed as Oil, Gas or Dry Hole) _____
Date well completed _____ 19____
Application for plugging filed _____ 19____
Application for plugging approved _____ 19____
Plugging commenced 1/23/67 _____ 19____
Plugging completed 1/28/67 _____ 19____
Reason for abandonment of well or producing formation depleted.

NORTH

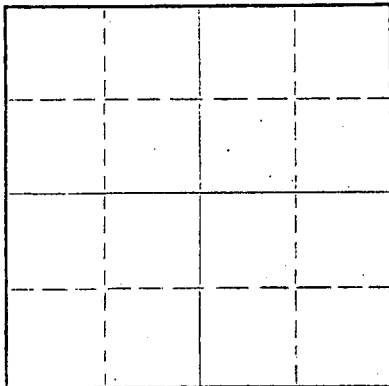

Locate well correctly on above
Section Plat

If a producing well is abandoned, date of last production _____ 19____
Was permission obtained from the Conservation Division or its agents before plugging was com-
menced? yes

Name of Conservation Agent who supervised plugging of this well Elving

Producing formation _____ Depth to top _____ Bottom _____ Total Depth of Well 4766 Feet

Show depth and thickness of all water, oil and gas formations.

OIL, GAS OR WATER RECORDS

CASING RECORD

FORMATION	CONTENT	FROM	TO	SIZE	PUT IN	PULLED OUT
				8 5/8	281	none
				4 1/2	4765	4215.45'

Describe in detail the manner in which the well was plugged, indicating where the mud fluid was placed and the method or methods used in introducing it into the hole. If cement or other plugs were used, state the character of same and depth placed, from _____ feet to _____ feet for each plug set.

Raised mast, cleaned cellar, checked hole to 4765'. Sanded back to 4700' and ran 3 sacks of cement. Rigged up on 4 1/2" casing, shot pipe at 4299' and 4240'. Worked pipe to 43" tension at 14 points. Shot pipe at 4210', worked pipe loose and pulled 65 joints of 4 1/2" casing, well flowed all day. Had trouble with slips. Finished pulling 4 1/2" casing, cleared floor. Loaded rack. Bridged hole at 245', 10' rock bridge and ran 25 sacks of cement. Mudded hole to 40', 10' rock bridge and ran 10 sacks of cement. Lowered mast, racked unit and tallied pipe. Moved out.

PLUGGING COMPLETE.

RECEIVED
STATE CORPORATION COMMISSION

FEB 2 1967

CONSERVATION DIVISION
Wichita, Kansas

(If additional description is necessary, use BACK of this sheet)

Name of Plugging Contractor KNIGHT CASING PULLING COMPANY
Address BOX 333 CHASE, KANSAS
405

STATE OF KANSAS, COUNTY OF RICE, ss.

NOEL J. KNIGHT

(employee of owner) or (owner or operator) of the above-described

well, being first duly sworn on oath, says: That I have knowledge of the facts, statements, and matters herein contained and the log of the above-described well as filed and that the same are true and correct. So help me God.

(Signature) Noel J. Knight
CHASE, KANSAS

(Address)

SUBSCRIBED AND SWORN TO before me this 31 day of Jan, 1967

My commission expires

Oct 22 - 1970

John J. Anderson
Notary Public.

WELL LOG

COMPANY: Bowers Drilling Company, Inc.
 CONTRACTOR: Bowers Drilling Company, Inc.
 FARM: Wright-Bevans #1
 LOCATION: CE/2-NE-SE Section 34-33S-12W
 Barber County, Kansas
 COMMENCED: June 29, 1966
 COMPLETED: July 11, 1966
 ELEVATION: 1573 Kelly Bushing

0 - 281	12 $\frac{1}{2}$ Surface hole	Set 8-5/8" casing at 281' with
281 - 1630	Redbed and Shale	250 sax
1630 - 2040	Shale and Shells	
2040 - 4305	Lime and Shale	
4305 - 4670	Lime	
4670 - 4720	Lime and Chert	Set 4-1/2" casing at 4765' with
4720 - 4766	Lime	125 sax
4766	T.D.	

LOG TOPS

Elgin Zone	3592 (-2019)
Elgin Sand	3668 (-2095)
Heebner	3810 (-2237)
Douglas Shale	3892 (-2319)
Lansing	3991 (-2418)
Base/Kansas City	4505 (-2932)
Mississippian	4688 (-3115)
T.D.	4766

RECEIVED
 STATE CORPORATION COMMISSION

FEB 2 1967

CONSERVATION DIVISION
 Wichita, Kansas

STATE OF KANSAS)
) SS
 COUNTY OF SEDGWICK)

I, Emil E. Bowers, do hereby certify that the above and foregoing is a true and correct copy of the copy of the log of the Wright-Bevans #1 located CE/2-NE-SE Section 34-33S-12W Barber County, Kansas, as reflected by the files of Bowers Drilling Company, Inc.

Emil E. Bowers

Subscribed and sworn to before me, a Notary Public, in and for Sedgwick County, Kansas, this 14th Day of July, 1966.

Elaine L. Winters

My commission expires May 5, 1970.

