


STATE OF KANSAS
STATE CORPORATION COMMISSION

Give All Information Completely
Make Required Affidavit
Mail or Deliver Report to:
Conservation Division
State Corporation Commission
11 No. Broadway
Wichita, Kansas

WELL PLUGGING RECORD

NORTH

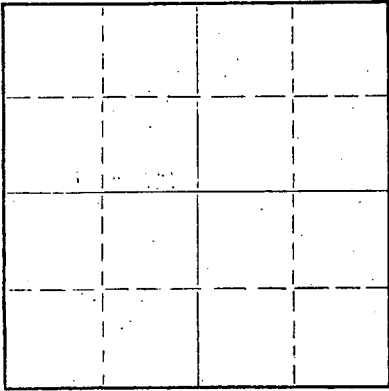

Locate well correctly on above
Section Plat

Barber County, Sec. 34 Twp. 33S Rge. 12 (W)
Location as "NE/CNW/SW" or footage from lines C E/2 NW/4
Lease Owner Bowers Drilling Company, Inc. & Aylward Drilling Company
Lease Name Wright Well No. 1
Office Address Wichita, Kansas
Character of Well (completed as Oil, Gas or Dry Hole) Dry Hole
Date well completed 10-14 19 65
Application for plugging filed 10-22 19 65
Application for plugging approved 10-14 19 65
Plugging commenced 10-14 19 65
Plugging completed 10-14 19 65
Reason for abandonment of well or producing formation Dry hole

If a producing well is abandoned, date of last production 19
Was permission obtained from the Conservation Division or its agents before plugging was commenced? Yes, verbally

Name of Conservation Agent who supervised plugging of this well
Producing formation Depth to top Bottom Total Depth of Well 4740 Feet
Show depth and thickness of all water, oil and gas formations.

OIL, GAS OR WATER RECORDS

CASING RECORD

FORMATION	CONTENT	FROM	TO	SIZE	PUT IN	PULLED OUT
				8-5/8"	314	

Describe in detail the manner in which the well was plugged, indicating where the mud fluid was placed and the method or methods used in introducing it into the hole. If cement or other plugs were used, state the character of same and depth placed, from feet to feet for each plug set.

Filled with heavy mud to 300'
Set first plug at 300" with
1/2 sack hulls, 25 sacks
cement
Filled with heavy mud to 40'
Set second plug at 40' with
1/2 sack hulls, 15 sacks
cement, 2 sacks in rathole

RECEIVED
STATE CORPORATION COMMISSION

OCT 25 1965

CONSERVATION DIVISION
Wichita, Kansas

(If additional description is necessary, use BACK of this sheet)
Name of Plugging Contractor Bowers Drilling Company, Inc.
Address 1434 Wichita Plaza

STATE OF KANSAS, COUNTY OF SEDGWICK, ss.
Emil E. Bowers (employee of owner) or (owner or operator) of the above-described well, being first duly sworn on oath, says: That I have knowledge of the facts, statements, and matters herein contained and the log of the above-described well as filed and that the same are true and correct. So help me God.

(Signature) Emil E. Bowers
1434 Wichita Plaza, Wichita, Kansas
(Address)

SUBSCRIBED AND SWORN TO before me this 22nd day of October, 19 65

Hanna J. Miller
Notary Public.

My commission expires May 1, 1966

WELL LOG

COMPANY: Bowers Drilling Company, Inc. and
 Aylward Drilling Company
 CONTRACTOR: Bowers Drilling Company, Inc.
 FARM: Wright #1
 LOCATION: C E/2 NW/4 Section 34-33S-12W
 Barber County, Kansas
 COMMENCED: October 4, 1965
 COMPLETED: October 14, 1965
 ELEVATION: 1525 Kelly Bushing

0 - 830	Redbed	Set 8-5/8" casing at 314' with 250
830 - 1132	Redbed and shells	sacks cement
1132 - 1710	Shale and Shells	
1710 - 3949	Lime and Shale	
3949 - 3980	Lime	
3980 - 4200	Lime and Shale	
4200 - 4540	Lime	
4540 - 4655	Lime and shale	
4655 - 4740	Lime	
4740	T. D.	

RECEIVED
 STATE CORPORATION COMMISSION

OCT 25 1965

CONSERVATION DIVISION
 Wichita, Kansas

SAMPLE TOPS:

Elgin Zone	3561	Lansing	3949
Heebner	3770	Base/Kansas City	4456
Douglas Shale	3848	Mississippian	4639

STATE OF KANSAS)
) SS
 COUNTY OF SEDGWICK)

I, Emil E. Bowers, do hereby certify that the above and foregoing is a true and correct copy of the copy of the log of Wright #1 located C E/2 NW/4 Section 34-33S-12W, Barber County, Kansas, as reflected by the files of Bowers Drilling Company, Inc.

Emil E. Bowers

Subscribed and sworn to before me, a Notary Public, in and for Sedgwick County, Kansas, this 22nd day of October, 1965.

Donna F. Miller
 Donna F. Miller, Notary Public

My commission expires May 1, 1966

