


WELL PLUGGING RECORD

Give All Information Completely
Make Required Affidavit
Mail or Deliver Report to:
Conservation Division
State Corporation Commission
211 No. Broadway
Wichita, Kansas

Barber County, Sec. 35 Twp. 33 Rge. 12 (E) W (W)

NORTH

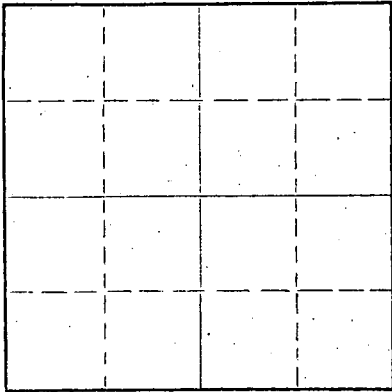

Locate well correctly on above Section Plat

Location as "NE/CNW/SW" or footage from lines SE SE NW
Lease Owner Beardmore Drilling Company
Lease Name Bevans Well No. 1
Office Address 827 Beacon Building, Wichita, Kansas
Character of Well (completed as Oil, Gas or Dry Hole) Dry Hole
Date well completed March 2 1959
Application for plugging filed " " 1959
Application for plugging approved " " 1959
Plugging commenced " " 1959
Plugging completed " " 1959
Reason for abandonment of well or producing formation Dry Hole

If a producing well is abandoned, date of last production 19
Was permission obtained from the Conservation Division or its agents before plugging was commenced? Yes

Name of Conservation Agent who supervised plugging of this well Bill Lackamp
Producing formation _____ Depth to top _____ Bottom _____ Total Depth of Well 5223 Feet
Show depth and thickness of all water, oil and gas formations.

OIL, GAS OR WATER RECORDS

CASING RECORD

FORMATION	CONTENT	FROM	TO	SIZE	PUT IN	PULLED OUT
Red Beds & Shale		0	252'	8-5/8"	252'	0

Describe in detail the manner in which the well was plugged, indicating where the mud fluid was placed and the method or methods used in introducing it into the hole. If cement or other plugs were used, state the character of same and depth placed, from _____ feet to _____ feet for each plug set.

0' to 35' - 10 Sacks Cement
35' - Wood Plug
35' to 180' - Heavy Mud
180' to 240' - 20 Sacks Cement
240' - Wood Plug
240' to 5223' - Heavy Mud

RECEIVED
STATE CORPORATION COMMISSION

MAR 24 1959

(If additional description is necessary, use BACK of this sheet)

Name of Plugging Contractor Beardmore Drilling Company
Address 827 Beacon Building, Wichita, Kansas

STATE OF KANSAS COUNTY OF SEDGWICK, ss.
Heber Beardmore (employee of owner) or (owner or operator) of the above-described well, being first duly sworn on oath, says: That I have knowledge of the facts, statements, and matters herein contained and the log of the above-described well as filed and that the same are true and correct. So help me God.

(Signature) Heber Beardmore
827 Beacon Building, Wichita, Kansas
(Address)

SUBSCRIBED AND SWORN TO before me this 6th day of March, 1959
Leonard P. Tolle
Leonard P. Tolle - Notary Public.

My commission expires January 28, 1960

PLUGGING
FILE SEC. 35 T. 33 R. 12W
BOOK PAGE 22 LINE 42

BEARDMORE ET AL
 #1 Bevans
 SE SE NW Section 35-33S-12W
 Barber County, Kansas

Drilled By: Beardmore Drilling Company
 Drilling Commenced: 2-11-59
 Drilling Completed: 3-2-59

Casing Record: 8-5/8" set at 251' with 150 sacks cement on 2-11-59. Cement circulated.

Elevations: 1588 KB
 1585 DF
 1582 Gr

<u>FORMATIONS</u>	<u>DEPTH</u>
Cellar	5
Red Bed	40
Red Bed	730
Shale and Shells	1450
Lime and Shale	2010
Lime	2260
Lime and Shale	3390
Sand	3416
Shale and Lime	3649
Sand	3770
Shale	3800
Shale and Lime	3990
Lime	4540
Lime and Shale	4630
Lime	4694
Chert	4720
Cherty Lime	4765
Lime	4903
Shale and Lime	5071
Viola Lime	5100
Lime	5155
Simpson Shale	5173
Sand	5205
Sand and Lime	5223
Rotary Total Depth	5223

RECEIVED
 STATE CORPORATION COMMISSION
 MAR 24 1959
 CONSTRUCTION DIVISION

<u>Tops</u>		<u>Tops</u>	
Elgins Sandstone	3644	Mississippi	4694
Base Elgin Sandstone	3770	Misener Sand	5065
Heebner	3800	Viola	5070
Lansing	3984	Simpson Sand	5173

DST #1 - 3648-3670 - Shut in 30 min., open 1 hr., good blow, shut in 30 min. Recovered 1980' salt water. IBHP 1507, FBHP 1438, IF 123, FF 920.

DST #2 - 4335-4395 - Shut in 20 min., open 1 hr., shut in 20 min. Recovered 690' salt water. IBHP 1707, FBHP 1617, IF 60, FF 348, Hydrostatic 2359.

DST #3 - 4697-4720 - Shut in 20 min., open 1 hr., shut in 20 min. Recovered 35' drilling mud. IBHP 968, FBHP 935, IF 0, FF 0, Hydrostatic 2625, Temperature 123°.

STATE OF KANSAS)
) ss
 COUNTY OF SEDGWICK)

I, the undersigned, being duly sworn on oath state that the above and within statement is a true and correct record and log of the well drilled on the location above described, to the best of my knowledge and belief.

PLUGGING
 FILE SEC. 35 T. 33 R. 12W
 BOOK PAGE 22 LINE 42

Beardmore

Subscribed and sworn to before me this 6th day of March, 1959.
 My Commission Expires:
 January 28, 1960

Leonard P. Tolle
 Leonard P. Tolle - Notary Public