

STATE OF KANSAS
STATE CORPORATION COMMISSION


Form CP-4

WELL PLUGGING RECORD

Give All Information Completely
Make Required Affidavit
Mail or Deliver Report to:
Conservation Division
State Corporation Commission
212 No. Market
Wichita, Kansas

Barber County. Sec. 26 Twp. 33S Rge. 12W (E) (W)
C-NW-SE

Location as "NE/CNWSW" or footage from lines
Lease Owner Carter Mandel Company
Lease Name Long Well No. 1
Office Address 904 Lubbock Nat'l Bank Bldg. Lubbock, Texas
Character of Well (completed as Oil, Gas or Dry Hole) Gas
Date well completed 12-31 1963
Application for plugging filed 9-16 1967
Application for plugging approved 9-30 1967
Plugging commenced 9-19 1967
Plugging completed 2:30 9:30 1967
Reason for abandonment of well or producing formation Non-commercial

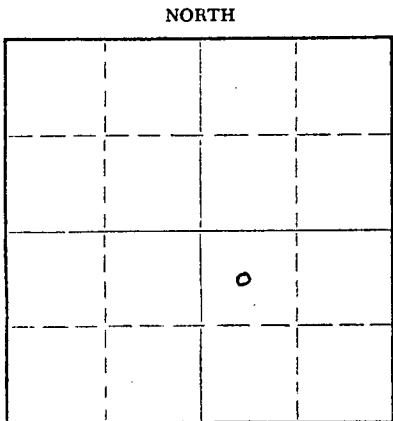

Locate well correctly on above
Section Plat

If a producing well is abandoned, date of last production April 30, 1967
Was permission obtained from the Conservation Division or its agents before plugging was commenced? Yes

Name of Conservation Agent who supervised plugging of this well Archie Elving
Producing formation Mississippi Depth to top 4617 Bottom Total Depth of Well 4657 Feet
Show depth and thickness of all water, oil and gas formations.

OIL, GAS OR WATER RECORDS

CASING RECORD

FORMATION	CONTENT	FROM	TO	SIZE	PUT IN	PULLED OUT
				85/8	319	None
				4 1/2	4218	

Describe in detail the manner in which the well was plugged, indicating where the mud fluid was placed and the method or methods used in introducing it into the hole. If cement or other plugs were used, state the character of same and depth placed, from feet to feet for each plug set.

Dumped chat in hole and plugged back from 4657 to 4585
Dump 4 sacks cement with dump bailer from 4585 to 4555
Ripped pipe at 4350 and 4218
Plugged well Build wood bridge at 300
Rock 10 foot From 300 to 290
Cement 25 sacks From 290 to 215
Mud From 215 to 40
Rock 10 foot From 40 to 30
Cement 16 sacks From 30 to top

RECEIVED
STATE CORPORATION COMMISSION

OCT 30 1967

CONSERVATION DIVISION
Wichita, Kansas

(If additional description is necessary, use BACK of this sheet)
Name of Plugging Contractor Clarke Corporation
Address Box 187 Medicine Lodge, Kansas

STATE OF TEXAS, COUNTY OF LUBBOCK, ss.
Charles S. Carter, partner in operator (employee of owner) or (owner or operator) of the above-described well, being first duly sworn on oath, says: That I have knowledge of the facts, statements, and matters herein contained and the log of the above-described well as filed and that the same are true and correct. So help me God.

(Signature) Charles S. Carter
904 Lubbock Natl. Bldg., Lubbock, Texas
(Address)

SUBSCRIBED AND SWORN TO before me this 10th day of October, 1967

My commission expires June 1, 1969

S. J. Mandel
Notary Public.

