


STATE OF KANSAS
CORPORATION COMMISSION

WELL PLUGGING RECORD

Give All Information Completely
Make Required Affidavit
Mail or Deliver Report to:
Conservation Division
State Corporation Commission
211 No. Broadway
Wichita, Kansas

Barber County, Sec. 26 Twp. 33S Rge. (E)12 (W)

Location as "NE/CNW/SW" or footage from lines SW/4 NE/4 NE/4
Lease Owner Skelly Oil Company
Lease Name L. T. Groendycke Well No. 1
Office Address Box 1650, Tulsa, Oklahoma
Character of Well (completed as Oil, Gas or Dry Hole) Dry Hole
Date well completed October 26, 1956
Application for plugging filed October 27, 1956
Application for plugging approved October 29, 1956
Plugging commenced October 27, 1956
Plugging completed October 27, 1956
Reason for abandonment of well or producing formation Dry Hole

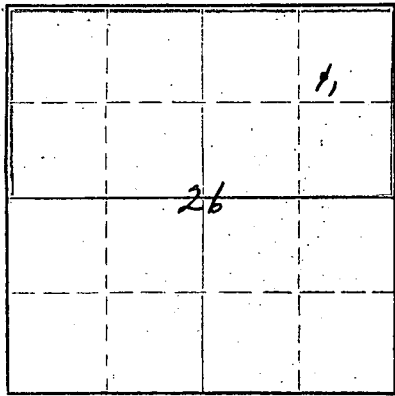

Locate well correctly on above
Section Plat

If a producing well is abandoned, date of last production 19
Was permission obtained from the Conservation Division or its agents before plugging was commenced? Yes

Name of Conservation Agent who supervised plugging of this well Mr. M. A. Rives
Producing formation _____ Depth to top _____ Bottom _____ Total Depth of Well 4630 Feet
Show depth and thickness of all water, oil and gas formations.

OIL, GAS OR WATER RECORDS

CASING RECORD

FORMATION	CONTENT	FROM	TO	OD SIZE	PUT IN	PULLED OUT
Mississippi Lime	Dry	4516'	4630'	8-5/8"	339' 0"	None

Describe in detail the manner in which the well was plugged, indicating where the mud fluid was placed and the method or methods used in introducing it into the hole. If cement or other plugs were used, state the character of same and depth placed, from _____ feet to _____ feet for each plug set.

Mud laden fluid 4630' to 300'
Wood plug 300'
20 sacks of cement 300' to 240'
Mud laden fluid 240' to 35'
Wood plug 35'
10 sacks of cement 35' to 6'
Surface soil 6' to 0'

FILED
CORPORATION COMMISSION
NOV - 7 1956
CONSERVATION DIVISION
Wichita, Kansas

Name of Plugging Contractor Chas. Hulme Drlg., Contr.
Address Box 36, Great Bend, Kansas

STATE OF Kansas, COUNTY OF Reno, ss.
H. E. Wamsley (employee of owner) of the above-described well, being first duly sworn on oath, says: That I have knowledge of the facts, statements, and matters herein contained and the log of the above-described well as filed and that the same are true and correct. So help me God.

(Signature) _____
Box 391, Hutchinson, Kansas (Address)

SUBSCRIBED AND SWORN TO before me this 6th day of November, 1956

My commission expires April 7, 1959
Josephine L. Johnson Notary Public.

PLUGGING
FILE SEC 26 T 33 R 12W
BOOK PAGE 111 LINE 12

SKELLY OIL COMPANY

NORTH				
SOUTH				

Well Record

Lease Name and No. 133930 Well No. 1 Elev. 11
 Lease Description 1/2 Section 25-32-12-9
Harbor County, Kansas (320 Acres)
 Location made October 5, 1956 by ...
990 feet from North line 990 feet from East line 11/4
... feet from South line ... feet from West line of Section

Work com'd 10/6 1956 Rig com'd 10/9 1956 Drig. com'd 10/9 1956 Drig. comp'd 10/2
 Rig Contractor Chas. Hulse Drilling Company
 Drilling Contractor Chas. Hulse Drig. Co., Great Bend, Kansas
 Rotary Drilling from 0' to 1630' Cable Tool Drilling from ... to ...

Commenced Producing Dry Hole 19... Initial Prod. before shot or acid ...
 Initial Prod. after shot or acid ...
 Dry Gas Well Press ... Volume ...
 Casing Head Gas Pressure ... Volume ...
 Braden Head (... Size) Gas Pressure ... Volume ...
 Braden Head (... Size) Gas Pressure ... Volume ...

PRODUCING FORMATION ... (Name) Top ... Bottom ... TOTAL DEPTH 463

CASING RECORD

OD	Size	Wt.	Thds.	Where Set	PULLED OUT			LEFT IN			KIND	Cond'n	Sacks Used	CEMENTING Method Employed
					Jts.	Feet	In.	Jts.	Feet	In.				
	4-5/8"	22.7	1	346'				0	339	0	...	225	Halliburton	

Liner Set at ... Length ... Perforated at ...
 Liner Set at ... Length ... Perforated at ...
 Packer Set at ... Size and Kind ...
 Packer Set at ... Size and Kind ...

SHOT OR ACID TREATMENT RECORD

	FIRST	SECOND	THIRD	FOURTH
Date				
Acid Used Size Shot		Gals. Qts.	Gals. Qts.	Gals. Qts.
Shot Between	Ft. and Ft.	Ft. and Ft.	Ft. and Ft.	Ft. and Ft.
Size of Shell				
Put in by (Co.)				
Length anchor				
Distance below Casing				
Damage to Casing or Casing Shoulder				

SIGNIFICANT GEOLOGICAL FORMATIONS

NAME	Top	Bottom	GAS		OIL		REMARKS
			From	To	From	To	
Hoebner Shale	3656'						
Lancing Linc	3619'						
Harnett Linc	4385'						
Mississippi Linc	4516'						

CLEANING OUT RECORDS

	DATE COMMENCED	DATE COMPLETED	PROD. BEFORE	PROD. AFTER	REMARKS
1st					See Reverse for other
2nd					" " "
3rd					" " "
4th					" " "

PLUGGING BACK AND DEEPENING RECORDS

	Date Commenced	Date Completed	No. Feet Plugged Back or Deepened	Prod. Before	Prod. After	REMARKS

RECORD OF FORMATIONS

FORMATION	TOP	BOTTOM	REMARKS <small>Indicate Casing Points Describe Shows of Oil Gas and Water, etc.</small>
Surface soil and red bed	0	55	
Red bed and gyp	55	346	Set and cemented 8-5/8" 22.75 S.W. J. steel casing (1" cond.) at 346' with 285 sacks of cement containing 2% aqueous, and 1% calcium chloride. Finished cementing at 12:00 P.M. 10/10/56. Cement circulated.
Red bed and shale	346	750	
Shale and shales	750	1150	
Shale and salt	1150	1200	
Shale and shales	1200	1400	
Sand, shale and shells	1500	1650	
Shale and lime	1650	1845	
Lime	1845	2040	
Lime and shale	2040	2130	
Shale	2130	2300	
Lime and shale	2300	3125	
Lime	3125	3385	
Shale	3385	3460	
Shale and sand	3460	3585	
Shale	3585	3675	
Lime and shale	3675	3710	
Lime	3710	3805	
Shale and lime	3805	3840	
Lime	3840	4040	
Shale and lime	4040	4100	
Lime	4100	4240	
Shale and lime	4240	4405	
Shale and cherty lime	4405	4441	
Shale and lime	4441	4500	
Lime	4500	4514	
White, opaque, black chert w/ fine pin point porosity and light to dark dead oil stain w/ some light tripolitic chert and green and gray shale	4514	4550	TOP MISSISSIPPI LIME 4514' TOP MISSISSIPPI LIME 4516' TOP MISSISSIPPI LIME 4519' TOP MISSISSIPPI LIME 4522' 
White, opaque and brown tripolitic oil stained and semi-transparent chert	4550	4551	Ben Johnston drill stem test No. 1, packer set at 4459', used 31' anchor, open 45 minutes, very weak blow of air for 1 minute, then nothing, recovered 70' of drilling mud, IRP-60, IRP-80, IRP-125 in 20 minutes.
White, opaque and brown tripolitic oil stained and semi-transparent chert	4551	4582	Good pinpoint porosity. Ben Johnston drill stem test No. 2 with packer set at 4550', used 31' anchor, open 1 1/2 hours, fair blow of air throughout test, recovered 630' of salt water, IRP-175, IRP-350, and IRP-525 in 20 minutes.
Intersixed, white opaque chert, tripolitic chert, gray shale and streaks of gray lime	4582	4604	Spotted stain in tripolitic chert, poor pinpoint porosity.
White, chalky to fine crystalline lime with blue to gray opaque chert, slightly sandy	4604	4613	No shows
White, fine crystalline chalky lime	4613	4630	Slightly cherty, no shows. Ben Halliburton drill stem test No. 3, packer set at 4607', used 31' anchor, open 20 minutes, IRP-60, open 1 hour, good blow throughout test, recovered 10' drilling mud, IRP-15, IRP-15, IRP-60 after 20 minutes. Ben Schlumberger survey.
TOTAL DEPTH	4630'		

Since no commercial production of oil or gas was encountered in drilling to the total depth of 4630', permits authority was granted to plug

On October 27, 1956, the well was plugged as follows:

Mud laden fluid	4550' to 300'
Mud plug	300'
10 sacks of cement	300' to 240'
Mud laden fluid	240' to 25'
10 sacks of cement	25' to 6'
Surface soil	6' to 0'

LOGS WITH DATA

<u>DEPTH</u>	<u>GRAIN SIZE DISTRIBUTION</u>
250'	1/2 D. fines
300'	3/4
750'	3/4
1000'	3/4
1250'	3/4
1500'	3/4
2000'	1
2250'	1
2500'	3/4
3000'	1
3690'	3/4
3800'	3/4
4550'	3/4

