


STATE OF KANSAS  
STATE CORPORATION COMMISSION

WELL PLUGGING RECORD

Give All Information Completely  
Make Required Affidavit  
Mail or Deliver Report to:  
Conservation Division  
State Corporation Commission  
211 No. Broadway  
Wichita, Kansas

Barber County, Sec. 25 Twp. 33S Rge. (E) 12 (W)  
Location as "NE/CNW/SW" or footage from lines 840' FNL 940' FWL NE/4  
Lease Owner Skelly Oil Company  
Lease Name J. W. Long Well No. 1  
Office Address Box 1650, Tulsa, Oklahoma  
Character of Well (completed as Oil, Gas or Dry Hole) Dry Hole  
Date well completed January 30, 19 56  
Application for plugging filed January 31, 19 56  
Application for plugging approved February 1, 19 56  
Plugging commenced February 13, 19 56  
Plugging completed February 16, 19 56  
Reason for abandonment of well or producing formation Dry Hole

NORTH

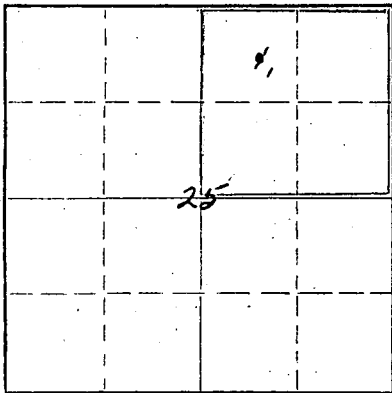

Locate well correctly on above Section Plat

If a producing well is abandoned, date of last production \_\_\_\_\_ 19\_\_\_\_  
Was permission obtained from the Conservation Division or its agents before plugging was commenced? Yes

Name of Conservation Agent who supervised plugging of this well Mr. M. A. Rives  
Producing formation \_\_\_\_\_ Depth to top \_\_\_\_\_ Bottom \_\_\_\_\_ Total Depth of Well 4645' Feet  
Show depth and thickness of all water, oil and gas formations.

OIL, GAS OR WATER RECORDS

CASING RECORD

FORMATION	CONTENT	FROM	TO	OD SIZE	PUT IN	PULLED OUT
<u>Mississippi</u>	<u>Dry</u>	<u>4526'</u>	<u>4645'</u>	<u>8-5/8"</u>	<u>351'0"</u> <u>4681'9"</u>	<u>None</u> <u>3519'11"</u>

Describe in detail the manner in which the well was plugged, indicating where the mud fluid was placed and the method or methods used in introducing it into the hole. If cement or other plugs were used, state the character of same and depth placed, from \_\_\_\_\_ feet to \_\_\_\_\_ feet for each plug set.

- Bridging plug 4625'
- Bridging plug 4615'
- Cement 4615' to 4581'
- Bridging plug 4562'
- 1/4 sack Cal-Seal 4562' to 4561'
- Sand 4561' to 4535'
- 5 sacks of cement 4535' to 4510'
- Heavy mud 4510' to 300'
- Crushed rock 300' to 295'
- 20 sacks of cement 295' to 235'
- Heavy mud 235' to 35'
- 10 sacks of cement 35' to 6'
- Surface soil 6' to 0'

(If additional description is necessary, use BACK of this sheet)



Name of Plugging Contractor Ace Pipe Pulling Company  
Address Box 304, Great Bend, Kansas

STATE OF Kansas COUNTY OF Reno ss.  
H. E. Wamsley (employee of owner) ~~not a public official~~ of the above-described well, being first duly sworn on oath, says: That I have knowledge of the facts, statements, and matters herein contained and the log of the above-described well as filed and that the same are true and correct. So help me God.


(Signature) \_\_\_\_\_  
Box 391, Hutchinson, Kansas  
(Address)

SUBSCRIBED AND SWORN to before me this 29th day of February, 1956

My commission expires April 7, 1959  
Josephine L. Johnson Notary Public.

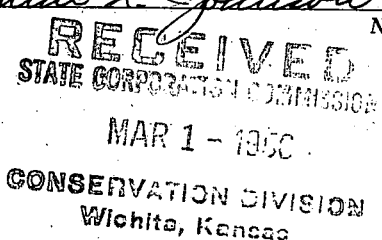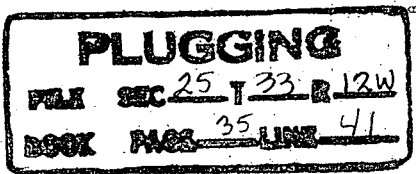

# SKELLY OIL COMPANY

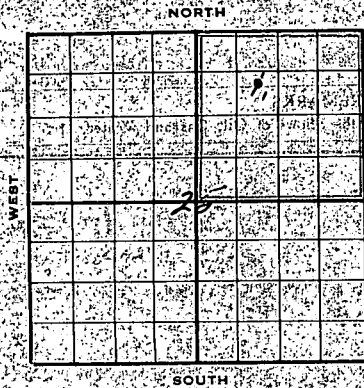

**Well Record**

Lease Name and No: J. A. Long Well No: 1 Elev: 14

Lease Description: SE/4 of Section 25-35-12

Barber County, Kansas (160 Acres)

Location made November 15, 1955 by Clude Inginer

860 feet from North line 840 feet from East line

860 feet from South line 840 feet from West line of Sec. 25

Work com'd 11/15 19 55 Rig com'd 11/17 19 55 Drig com'd 11/17 19 55 Drig com'd 12/7

Rig Contractor: Clude Westworth Drilling Co., Inc.

Drilling Contractor: Clude Westworth Drilling Co., Inc., Tulsa, Oklahoma

Rotary Drilling from 0' to 4065' Cable Tool Drilling from To complete to

Commenced Producing 12/17/55 19  Initial Prod. before shot or acid

Initial Prod. after shot or acid

Dry Gas Well Press.  Volume

Casing Head Gas Pressure  Volume

Braden Head (  Size  ) Gas Pressure  Volume

Braden Head (  Size  ) Gas Pressure  Volume

PRODUCING FORMATION 12/17/55 (Name)  Top  Bottom  TOTAL DEPTH 4065

### CASING RECORD

Casing Size	Wt.	Thds.	Where Set	PULLED OUT			LEFT IN			KIND	Cond'n	Sacks Used	CEMENTING Method Employ
				Jts	Feet	In.	Jts	Feet	In.				
8-5/8	22.75	1	359'				9	351'	0	Aruco		225	Halliburton
5-7/8	11.4	11	4065'	11	351'	11	36	1161'	10	55 28		200	Halliburton
16-5/8"			casing set										

Liner Set at  Length  Perforated at

Liner Set at  Length  Perforated at

Packer Set at  Size and Kind

Packer Set at  Size and Kind

### SHOT OR ACID TREATMENT RECORD

	FIRST	SECOND	THIRD	FOURTH
Date	<u>12/17/55</u>	<u>12/17/55</u>	<u>12/17/55</u>	
Acid Used Size Shot	<u>350</u>	<u>350</u>	<u>300</u>	
Shot Between	<u>4074 Ft. and 4044 Ft.</u>	<u>4074 Ft. and 4010 Ft.</u>	<u>4074 Ft. and 4070 Ft.</u>	<u></u>
Size of Shell				<u>FOR REPAIR</u>
Put in by (Co.)	<u>Halliburton</u>	<u>Halliburton</u>	<u>Halliburton</u>	<u>FOR REPAIR</u>
Length anchor				<u>REPAIR</u>
Distance below Casing				
Damage to Casing or Casing Shoulder				

### SIGNIFICANT GEOLOGICAL FORMATIONS

NAME	Top	Bottom	GAS		OIL		REMARKS
			From	To	From	To	

### CLEANING OUT RECORDS

	DATE COMMENCED	DATE COMPLETED	PROD. BEFORE	PROD. AFTER	REMARKS
1st					See Reverse for o
2nd					" " "
3rd					" " "
4th					" " "

### PLUGGING-BACK AND DEEPENING RECORDS

	Date Commenced	Date Completed	No. Feet Plugged Back or Deepened	Prod. Before	Prod. After	REMARKS

# RECORD OF FORMATIONS

FORMATION	TOP	BOTTOM	REMARKS


ACID TREATMENT NO. 2 - Between 4604' and 4610'

Treatment put in 12/13/35 by Halliburton, using 250 gallons of acid and 120 barrels of oil.

TIME	CP	IP	REMARKS
5:34 pm			Start acid
5:38 pm			Start flush
6:00 pm	500		Acid on bottom
6:10 pm	1350		
6:17 pm	1300		
6:26 pm	1200		Finished flush

Swabbed through 5 1/2" casing 4 hours, 112 barrels of treating oil and 3 barrels of spent acid water; then swabbed through 5 1/2" casing 7 hours, 9 gallons of water with light foam of oil per hour.

Set Lane-Wells cast iron bridging plug at 4600' and plugged back from 4600' to 4597' with 1/3 sack of Cal-Seal - Loaded hole with 112 barrels of oil. Perforated 5 1/2" casing from 4564' to 4596' with 190 holes by Lane-Wells. Ran 2" tubing and set Halliburton HM packer at 4542'. Treated through 2" tubing with 500 gallons of 30% acid as follows:

ACID TREATMENT NO. 3 - Between 4564' and 4596'

Treatment put in 12/15/35 by Halliburton, using 500 gallons of acid and 22 barrels of oil.

TIME	CP	IP	REMARKS
1:35 am			Start acid
2:21 am			Start load
3:00 am	500	2100	Acid on bottom
3:13 am	500	1450	Acid out
3:15 am	500	1300	Treatment completed

Swabbed through 2" tubing 1/2 hour, well began to flow. Flowed through 2" tubing 1 hour, 22 barrels of treating oil, no water, gas gauged 750 M.C.F. Flowed through 2" tubing 3 hours to clean up hole, gas gauged 500 M.C.F. Treated through 2" tubing with Halliburton Vis-O-Free as follows:

VIS-O-FREE TREATMENT NO. 1 - Between 4564' to 4596'

Used 2000' of sand  
110 barrels heavy oil, and 64 barrels oil to fill tubing  
Maximum IP-1400  
Time 14 minutes

On December 16, flowed through 2" tubing, 3/4" chokes, 23 hours, 193 barrels of treating oil, gas gauged 500 M.C.F., well quit flowing. Swabbed through 2" tubing 4 hours, 25 barrels of load oil, gas gauged 500 M.C.F. Pulled 2" tubing and packer, then swabbed through 5 1/2" casing 3 hours, 78 barrels of load oil and found 15' of sand in hole. Cleaned out with sand pump, then swabbed through 5 1/2" casing 3 hours, 61 barrels of load oil, gas gauged 375 M.C.F. Ran 2" tubing with Halliburton HM retainer set at 4596' and tried to cement off perforations from 4564' to 4596' with 100 sacks of common cement, retainer failed to hold. Reversed out cement, drilled cement retainer and cement plug, and cleaned out to 4585'. Swabbed out 40 barrels of load oil and drew Lane-Wells bridging plug from 4600' to 4615'.

Perforated 5 1/2" casing from 4564' to 4596' with 24 holes by Lane-Wells. Ran 2" tubing and set Halliburton HM retainer at 4590' and cemented off perforations from 4564' to 4596' and 4604' to 4610' with 100 sacks of common cement, maximum IP-3500. Pulled 2" tubing and shut down for cement to set.

On December 26, swabbed and bailed hole dry. Drilled cement retainer at 4590', drilled cement plug and cleaned out to 4576'. Swabbed and bailed hole dry, 5 1/2" casing tested dry. Perforated 5 1/2" casing from 4565' to 4575' with 60 holes by Lane-Wells, show of gas, too small to gauge. Unable to get baller below 4565'; ran 4-1/4" and 6-7/8" wedges and wedged out 4 1/2" casing from 4565' to 4575'. Bailed and tested 1 hour, tested dry. Treated through 5 1/2" casing with 250 gallons of Halliburton 30% acid as follows:

ACID TREATMENT NO. 4 - Between 4565' and 4575'

Treatment put in 12/27/35 by Halliburton, using 250 gallons of acid and 125 barrels of oil.

TIME	CP	IP	REMARKS
2:06 am			Start acid
2:11 am			Start load
2:32 am	2200		Acid on bottom
4:47 am	2150		Acid out

Swabbed through 5 1/2" casing 4 hours, 112 barrels of oil used in treating and 6 barrels of acid water with show of gas too small to gauge. Ran 2" tubing and set Halliburton HM packer at 4595'. Retreat through 2" tubing with 250 gallons of Halliburton 30% acid as follows:

ACID TREATMENT NO. 5 - Between 4549' to 4575'

Treatment put in 12/20/55 by Halliburton, using 250 gallons of acid and 18 barrels of oil to flush.

TIME	CP	TP	REMARKS
1:15 pm	8000		Start acid
1:38 pm	8000	1000	Start flush
1:43 pm	8000	7000	Acid on bottom
5:56 pm	8000	34000	Finished flush.

Run Sand-Oil-Frac treatment as follows:

SAND OIL FRAC TREATMENT NO. 1 - Between 4555' and 4575'

Used 30000# of sand  
96 barrels heavy oil  
134 barrels oil to fill and flush tubing  
Maximum TP-47000, minimum TP-39000

Swabbed through 2" tubing 10 hours, 63 barrels of treating oil, 6 barrels of spent acid water, gas too small to gauge. Pulled 2" tubing and Halliburton HM packer; reran 2" tubing and set Halliburton HM retainer at 4546'. Cemented off perforations from 4555' to 4575' with 75 sacks of cement, maximum TP-35000. Pulled 2" tubing and shut down for cement to set.

Drilled cement and cleaned out to 4605'. Perforated 3 1/2" casing from 4571' to 4594' with 138 holes by Lane-Wells Kone shots; bailed and tested 1 hour, tested dry. Ran 2" tubing with Halliburton HM packer and well started making small amount of gas, too small to gauge.

Set Halliburton HM packer at 4555' and ran Halliburton Sand-Oil-Frac as follows:

SAND OIL FRAC TREATMENT NO. 2 - Between 4571' and 4594'

Used 1200 gallons diesel fuel to load hole  
60000# sand  
96 barrels of heavy oil  
142 barrels oil to flush  
Maximum TP-50000, minimum TP-39000  
Time 41 minutes

Swabbed through 2" tubing 4 hours, 30 barrels of treating oil and well began to flow. Flowed through 2" tubing 10 hours, 50 barrels of treating oil, no water, gas gauged 180 M.C.F. On January 5, swabbed through 2" tubing 24 hours, 56 barrels of treating oil and 43 barrels of water, gas gauged 180 M.C.F. Pulled 2" tubing and HM packer; reran 2" tubing with Halliburton cement retainer set at 4530' and cemented off perforations from 4571' to 4594' with 74 sacks of common cement, maximum TP-39000. Finished 3:00 p.m. 1/6/56. Pulled 2" tubing and shut down for cement to set.

Swabbed and bailed hole dry to retainer at 3550', drilled retainer and cement plug and cleaned out to 4581' and 3 1/2" casing tested dry. Perforated 3 1/2" casing from 4565' to 4578' with 94 Kone shots by Lane-Wells. Swabbed through 3 1/2" casing 9 hours, 1 1/2 barrels of water per hour, gas too small to gauge. Ran 2" tubing and set Halliburton HM packer at 4548', loaded annulus with 90 barrels of oil, ran 1000 gallons of kerosene down 2" tubing, TP-56000, and treated through 2" tubing with 250 gallons of Halliburton HCl acid as follows:

ACID TREATMENT NO. 6 - 4555' to 4574'

Treatment put in 1/10/56 by Halliburton, using 250 gallons of acid and 18 barrels of oil to flush.

TIME	CP	TP	REMARKS
9:33 pm	10000	47500	Start acid
9:38 pm	10000	55000	Start load
9:43 pm	10000	56000	Acid on bottom
9:50 pm	10000	60000	150 gallons of acid in
9:52 pm	10000	69600	250 gallons of acid in
9:55 pm	10000	69000	Treatment completed

Tried to run Halliburton Sand-Oil-Frac as follows:

SAND OIL FRAC TREATMENT NO. 3 - Between 4565' and 4574'

Tried to run 40000# of sand and 72 barrels heavy crude oil  
Formation took only 800# sand and 30 barrels oil at 53000-TP

Swabbed through 2" tubing 3 hours, 45 barrels treating oil and no water, gas too small to gauge. On January 11, swabbed through 2" tubing 3 hours, 15 barrels load oil and gas gauged 150 M.C.F. Pulled 2" tubing and packer, swabbed hole down to 4531', and recovered 110 barrels of load oil. Bailed and cleaned out hole, gas gauged 300 M.C.F.

Ran 2" tubing and set Halliburton HM packer at 4548', loaded annulus with 90 barrels of oil, and pumped 50 barrels of oil into formation from 4565' to 4574'. Tried to Sand-Oil-Frac and packer failed to hold. Pulled tubing and packer, reran 2" tubing and set Halliburton HM packer at 4555', and ran Sand-Oil-Frac treatment as follows:

WATER-OIL-FLAC TREATMENT NO. 1 - Between 4565' and 4574'

Pumped 60 barrels oil into formation  
 Maximum TP-7500, minimum 6000  
 Used 1000 #2-3-Gel mixed with 100 gals. kerosene  
 Maximum TP-6500

Swabbed through 2" tubing 16 hours, 45 barrels of treating oil, gas too small to gauge. Pulled 2" tubing and packer, then swabbed through 5 1/2" casing 16 hours, 71 barrels of treating oil, gas gauged 64 M.C.F. On January 13, swabbed through 5 1/2" casing 24 hours, 21 barrels treating oil, gas gauged 66 M.C.F. On January 16, ran 2" tubing and set Halliburton JM packer at 4542', loaded annulus with 90 barrels of oil and treated through 2" tubing with 250 gallons of Halliburton HCA acid as follows:

ACID TREATMENT NO. 2 - Between 4565' and 4574'

Treatment put in 1/16/56 by Halliburton, using 250 gallons of acid and 30 barrels of oil.

TIME	CP	TP	REMARKS
3:13 pm	1500		Start acid
3:15 pm	1500		Start load
3:16 pm	1500	4500	Acid on bottom
3:25 pm	1500	4000	Acid out

Ran Hydratrac treatment as follows:

HYDRATRAC TREATMENT NO. 1 - Between 4565' and 4574'

Used 1000 #2-3-Gel  
 10 gallons breaker agent  
 1500 gallons of kerosene  
 40 barrels oil to flush  
 Maximum TP-5700, minimum TP-3150  
 Time 30 minutes

Pulled 2" tubing and JM packer. Swabbed through 5 1/2" casing 9 to 214 barrels of load oil, 6 barrels of acid water, and 9 barrels of formation water, gas gauged 375 M.C.F. On January 13, swabbed through 5 1/2" casing 24 hours, 34 barrels of load oil and 54 barrels of water, gas gauged 370 M.C.F.

On January 19, set Baker cont iron bridging plug at 4562' and plugged back from 4562' to 4561' with 1/4 sack of Val-Seal. Perforated 5 1/2" casing from 4550' to 4560' with 60 holes by Lang-cells; beiled and tested 3 hours, no recovery of oil or water, small amount of gas, no gauge. Treated through 5 1/2" casing with 250 gallons of Halliburton HCA acid as follows:

ACID TREATMENT NO. 3 - Between 4550' and 4560'

Treatment put in 1/19/56 by Halliburton, using 250 gallons of acid and 120 barrels of oil.

TIME	CP	TP	REMARKS
5:10 pm			Start acid
5:15 pm			Start flush
5:42 pm	750		Acid on bottom
5:48 pm	100		
5:51 pm	400		Finished flush

Swabbed through 5 1/2" casing 12 hours, 120 barrels of treating oil, 6 barrels of acid water and 24 barrels of formation water, gas gauged 375 M.C.F. On January 20, ran 2" tubing and set Halliburton JM packer at 4532'. Loaded annulus with 75 barrels of oil and tried to treat with Halliburton Hydratrac as follows:

HYDRATRAC TREATMENT NO. 2 - Between 4550' and 4560'

Used 8000 of #2-3-Gel  
 90 gallons breaker agent  
 2500 gallons of kerosene  
 2500 of sand (formation took only 1000 of sand)  
 1700 gallons of kerosene  
 Maximum TP-7200  
 Used 75 barrels of oil to fill and flush  
 Time 35 minutes

Pulled 2" tubing and packer. Swabbed through 5 1/2" casing 20 hours, 140 barrels of treating oil and gas gauged 60 M.C.F. Pumped 500 galls of kerosene down 5 1/2" casing and treated through 5 1/2" casing with 1000 gallons of acid as follows:

ACID TREATMENT NO. 4 - Between 4550' and 4560'

Treatment put in 1/22/56 by Halliburton, using 250 gallons of acid (15%) and 750 gallons of HV acid, and 120 barrels of oil.

TIME	CP	TP	REMARKS
4:14 pm			Start acid
4:48 pm			Start flush
5:05 pm	2750		Acid on bottom
5:11 pm	1150		

Worked through 5 1/2" casing 9 hours, 120 barrels of treating oil, 90 barrels of lead oil, 6 barrels of kerosene and 24 barrels of spent acid water, gas gauged 475 M.C.F. On January 23, worked through 3 1/2" casing 24 hours, 52 barrels of 24 gravity oil and 39 barrels of water, gas gauged 450 M.C.F.

Run 2" tubing. SI CP-900, SI TP-700. Flowed through 2" tubing, 18 hours, 3/4" choke, 11 barrels of formation oil and 23 barrels of water, flowing CP-470, flowing TP-500, gas gauged 200 M.C.F. On January 26, flowed through 2" tubing 21 hours, 3/4" choke, 5 barrels of oil and 18 barrels of water, gas gauged 150 M.C.F., flowing CP-370, flowing TP-400. On January 27, flowed through 2" tubing 12 hours, 3/4" choke, 1 barrel of oil and 9 barrels of water, gas gauged 150 M.C.F., flowing CP-360, flowing TP-400. Shut in 12 hours, SI CP-900, SI TP-840. On January 28, flowed through 2" tubing 6 hours, 1/64" choke, 9 barrels of water, VCP-300, VCP-700, gas gauged 10 M.C.F. Choke press off, SI CP-900, SI TP-840. On January 29, flowed through 2" tubing with 2/64" choke 6 hours, 12 barrels of water, gas gauged 53 M.C.F., VCP-300, VCP-900. On January 30, flowed through 2" tubing 24 hours, 1/64" choke, 64 barrels of water, gas gauged 50 M.C.F., VCP-900, VCP-450.

As there were no shows of oil or gas in commercial quantities, regular authority was granted to plug and abandon the well.

On February 13, moved in tools of Ice Pipe Pulling Company and plugged the well as follows:

Sand 4501' to 4595'  
5 sacks of cement 4595' to 4510'

Shot off 5 1/2" casing at 3510' and pulled 3519' (11' of 5 1/2" casing, 14' SR thd., B-2, J-55, casing (11 cond.))

Heavy mud 4510' to 300'  
Crushed rock 300' to 295'  
20 sacks of cement 295' to 235'  
Heavy mud 235' to 15'  
10 sacks of cement 15' to 0'  
Surface soil 0' to 0'

Plugged and abandoned February 16, 1955.

well

DEPTH	DIPPER BEAM DATA	
	ANGLE OF REFLECTION	
250'	0	degrees
500'	0	"
750'	0	"
1000'	0	"
1250'	0	"
1500'	0	"
1750'	0	"
2000'	0	"
2250'	0	"
2500'	0	"
2750'	1	"
3050'	2	"
3250'	0	"