

For KCC Use: 11-5.02  
 Effective Date: \_\_\_\_\_  
 District #: \_\_\_\_\_  
 SGA?  Yes  No

**KANSAS CORPORATION COMMISSION**  
**OIL & GAS CONSERVATION DIVISION**  
**NOTICE OF INTENT TO DRILL**  
*Must be approved by KCC five (5) days prior to commencing well*

Form C-1  
 September 1999  
 Form must be Typed  
 Form must be Signed  
 All blanks must be Filled

Expected Spud Date November 10 2002  
month day year

Spot NE - NW - NW Sec. 24 Twp. 31 S S. R. 13 W  East  West  
330 feet from 1 (circle one) Line of Section  
990 feet from 2 (circle one) Line of Section  
 Is SECTION  Regular  Irregular?

OPERATOR: License# 31406  
 Name: Prairie Resources, Inc.  
 Address: 1016 Amanda Pines Drive  
 City/State/Zip: Parker, CO 80138  
 Contact Person: Robert W. Packard  
 Phone: (303) 840-3313

(Note: Locate well on the Section Plat on reverse side)  
 County: Barber  
 Lease Name: Packard Well #: 1-24  
 Field Name: Nurse

CONTRACTOR: License# 5929  
 Name: Duke Drilling Co., Inc.

Is this a Prorated / Spaced Field?  Yes  No  
 Target Formation(s): Douglas, Mississippi  
 Nearest Lease or unit boundary: 330'  
 Ground Surface Elevation: 1580' Estimated \_\_\_\_\_ feet MSL

- |   |                                   |   |  |
|---|-----------------------------------|---|--|
| <input checked="" type="checkbox"/> Oil | <input type="checkbox"/> Enh Rec  | <input type="checkbox"/> Infield              | <input checked="" type="checkbox"/> Mud Rotary |
| <input type="checkbox"/> Gas            | <input type="checkbox"/> Storage  | <input checked="" type="checkbox"/> Pool Ext. | <input type="checkbox"/> Air Rotary            |
| <input type="checkbox"/> OWWO           | <input type="checkbox"/> Disposal | <input type="checkbox"/> Wildcat              | <input type="checkbox"/> Cable                 |
| <input type="checkbox"/> Seismic;       | # of Holes                        | <input type="checkbox"/> Other                |  |
| <input type="checkbox"/> Other          |                                   |   |  |

Water well within one-quarter mile: Yes  No   
 Public water supply well within one mile:  Yes  No  
 Depth to bottom of fresh water: 150'  
 Depth to bottom of usable water: 180'

If OWWO: old well information as follows:  
 Operator: \_\_\_\_\_  
 Well Name: \_\_\_\_\_  
 Original Completion Date: \_\_\_\_\_ Original Total Depth: \_\_\_\_\_

Surface Pipe by Alternate: XX 1 2  
 Length of Surface Pipe Planned to be set: 200'  
 Length of Conductor Pipe required: N/A NONE  
 Projected Total Depth: 4650'  
 Formation at Total Depth: Simpson

Directional, Deviated or Horizontal wellbore?  Yes  No  
 If Yes, true vertical depth: \_\_\_\_\_  
 Bottom Hole Location: \_\_\_\_\_  
 KCC DKT #: \_\_\_\_\_

Water Source for Drilling Operations:  
 Well \_\_\_\_\_ Farm Pond XX Other \_\_\_\_\_  
 DWR Permit #: \_\_\_\_\_  
 (Note: Apply for Permit with DWR )  
 Will Cores be taken?  Yes  No  
 If Yes, proposed zone: \_\_\_\_\_

**AFFIDAVIT**

The undersigned hereby affirms that the drilling, completion and eventual plugging of this well will comply with K.S.A. 55-101, et. seq.  
 It is agreed that the following minimum requirements will be met:

1. Notify the appropriate district office **prior** to spudding of well;
2. A copy of the approved notice of intent to drill **shall be** posted on each drilling rig;
3. The minimum amount of surface pipe as specified below **shall be set** by circulating cement to the top; in all cases surface pipe **shall be set** through all unconsolidated materials plus a minimum of 20 feet into the underlying formation.
4. If the well is dry hole, an agreement between the operator and the district office on plug length and placement is necessary **prior to plugging**;
5. The appropriate district office will be notified before well is either plugged or production casing is cemented in;
6. If an ALTERNATE II COMPLETION, production pipe shall be cemented from below any usable water to surface within **120 days** of spud date. **In all cases, NOTIFY district office** prior to any cementing.

I hereby certify that the statements made herein are true and to the best of my knowledge and belief.

Date: October 27, 2002 Signature of Operator or Agent: Robert W. Packard Title: President

**For KCC Use ONLY**  
 API # 15 - 007-22724-00-00  
 Conductor pipe required NONE feet  
 Minimum surface pipe required 200 feet per Alt. 1  
 Approved by: RJP 10-31-02  
 This authorization expires: 5-1-03  
(This authorization void if drilling not started within 6 months of effective date.)  
 Spud date: \_\_\_\_\_ Agent: \_\_\_\_\_

- Remember to:**
- File Drill Pit Application (form CDP-1) with Intent to Drill;
  - File Completion Form ACO-1 within 120 days of spud date;
  - File acreage attribution plat according to field proration orders;
  - Notify appropriate district office 48 hours prior to workover or re-entry;
  - Submit plugging report (CP-4) after plugging is completed;
  - Obtain written approval before disposing or injecting salt water.

24 31 130

**IN ALL CASES PLOT THE INTENDED WELL ON THE PLAT BELOW**

*Plat of acreage attributable to a well in a prorated or spaced field*

RECEIVED

OCT 30 2032

If the intended well is in a prorated or spaced field, please fully complete this side of the form. If the intended well is in a prorated or spaced field complete the plat below showing that the well will be properly located in relationship to other wells producing from the common source of supply. Please show all the wells and within 1 mile of the boundaries of the proposed acreage attribution unit for gas wells and within 1/2 mile of the boundaries of the proposed acreage attribution unit for oil wells.

API No. 15 - \_\_\_\_\_

Operator: Prairie Resources, Inc.

Lease: Packard

Well Number: # 1-24

Field: Nurse

Number of Acres attributable to well: 160

QTR / QTR / QTR of acreage: NE - NW - NW

Location of Well: County: Barber

330 feet from S  (circle one) Line of Section

990 feet from E  (circle one) Line of Section

Sec. 24 Twp. 31 S S. R. 13 W  East  West

Is Section  Regular or  Irregular



If Section is Irregular, locate well from nearest corner boundary.

Section corner used:  NE  NW  SE  SW

**PLAT**

(Show location of the well and shade attributable acreage for prorated or spaced wells.)

(Show footage to the nearest lease or unit boundary line.)

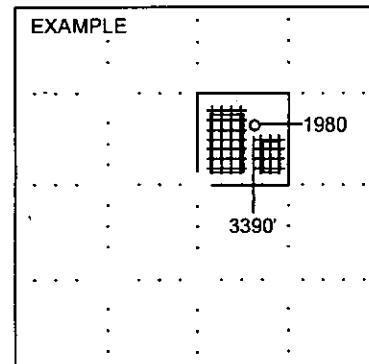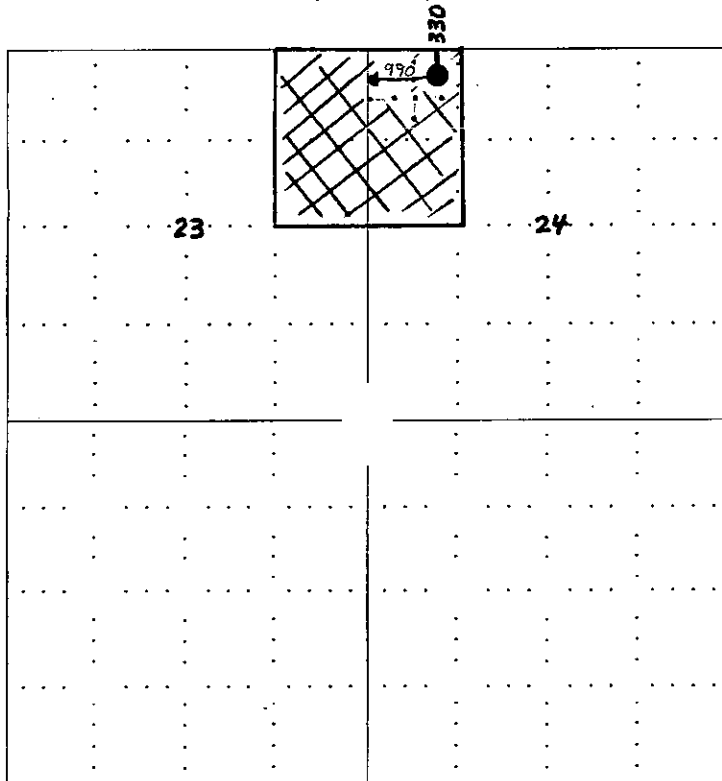

SEWARD CO.

NOTE: In all cases locate the spot of the proposed drilling location.

**BARBER COUNTY**

In plotting the proposed location of the well, you must show:

1. The manner in which you are using the depicted plat by identifying section lines, i.e. 1 section, 1 section with 8 surrounding sections, 4 sections, etc.
2. The distance of the proposed drilling location from the section's south / north and east / west.
3. The distance to the nearest lease or unit boundary line.
4. If proposed location is located within a prorated or spaced field a certificate of acreage attribution plat must be attached: (C0-7 for oil wells; CG-8 for gas wells).