

CARD MUST BE TYPED

State of Kansas

CARD MUST BE SIGNED

NOTICE OF INTENTION TO DRILL

(see rules on reverse side)

*CORRECTION

8-15-85

Starting Date 8-12-85
month day year

API Number 15— 007-22, 052-00-00 — East

OPERATOR: License # 5171
Name TXO Production Corp.
Address 200 W. Douglas, Suite 300
City/State/Zip Wichita, KS 67202
Contact Person Jerry W. Collins
Phone 316-265-9441

* Approx SE NE Sec. 15.. Twp. 33. S, Rg. 12... X West
* 3040 Ft. from South Line of Section
* 920 Ft. from East Line of Section

(Note: Locate well on Section Plat on reverse side)

CONTRACTOR: License # 5107
Name H-30 Drilling, Inc.
City/State Wichita, KS

Nearest lease or unit boundary line 920 feet
County Barber

Lease Name HARBAUGH Well # 1
Ground surface elevation TBD feet MSL

Well Drilled For: Well Class: Type Equipment:
 Oil SWD Infield Mud Rotary
 Gas Inj Pool Ext. Air Rotary
 OWWO Expl Wildcat Cable

Domestic well within 330 feet: ___yes no
Municipal well within one mile: ___yes no
Surface pipe by Alternate: 1 ___ 2 ___

If OWWO: old well info as follows:

Depth to bottom of fresh water 100
Depth to bottom of usable water 200
Surface pipe planned to be set 400
Projected Total Depth 0 feet
Formation Lansing

Operator
Well Name
Comp Date Old Total Depth

I certify that well will comply with K.S.A. 55-101, et seq., plus eventually plugging hole to KCC specifications. *f*

Date 8-13-85 Signature of Operator or Agent *Jerry W. Collins* Title.. Drlg. & Completion Engr.


For KCC Use:
Conductor Pipe Required feet: Minimum Surface Pipe Required feet per Alt. 1 2
This Authorization Expires ~~12-31-85~~ 12-31-86 Approved By ~~8-15-85~~ 6-3-85

RECEIVED
STATE CORPORATION COMMISSION

Must be filed with the K.C.C. five (5) days prior to commencing well
This card void if drilling not started within six (6) months of date received by K.C.C.

ATIG 4 5 1985

CONSERVATION DIVISION
A Regular Section of Land
1 Mile = 5,280 Ft.

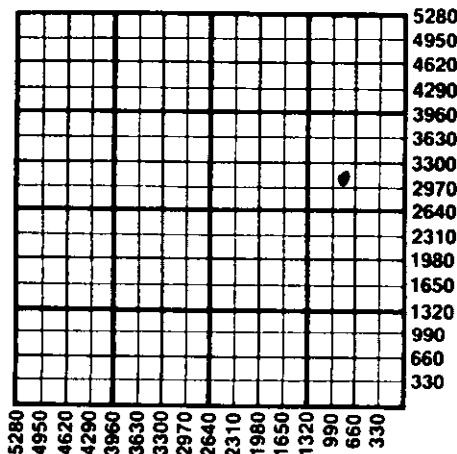

Important procedures to follow:

1. Notify District office before setting surface casing.
2. Set surface casing by circulating cement to the top.
3. File completion forms ACO-1 with K.C.C. within 90 days of well completion, following instructions on ACO-1, side 1, and including copies of wireline logs.
4. Notify District office 48 hours prior to old well workover or re-entry.
5. Prior to filing Intent, prepare a proposed plugging plan in case well is D & A, then obtain approval of plan when calling district office prior to setting surface pipe.
6. Submit plugging report (CP-4) to K.C.C. after plugging is completed.
7. Obtain an approved injection docket number before disposing of salt water.
8. Notify K.C.C. within 10 days when injection commences or terminates.
9. If an alternate 2 completion, cement in the production pipe from below any usable water to surface within 120 days of spud date.

State Corporation Commission of Kansas
Conservation Division
200 Colorado Derby Building
Wichita, Kansas 67202
(316) 263-3238