

FOR KCC USE:

EFFECTIVE DATE: 5-16-94

DISTRICT # 1

SGA? Yes  No

State of Kansas  
NOTICE OF INTENTION TO DRILL

Must be approved by the K.C.C. five (5) days prior to commencing well

FORM C-1 7/9-  
FORM MUST BE TYPE!  
FORM MUST BE SIGNED!  
ALL BLANKS MUST BE FILLED!

Expected Spud Date 5/25/94 month day year  
Approx SW NE NW Sec 18 Twp 33 S. Rg 12S East:  West:

OPERATOR: License # 8061  
Name: Oil Producers, Inc. of Kansas  
Address: P.O. Box 8647  
City/State/Zip: Wichita, Ks. 67208  
Contact Person: John S. Weir  
Phone: 316.681-0231

1440 feet from SOUTH North line of Section  
3630 feet from East West line of Section  
IS SECTION  REGULAR  IRREGULAR

(NOTE: Locate well on the Section Plat on Reverse Side  
County: Barber  
Lease Name: Bartholow Well #: #2

Field Name: \_\_\_\_\_  
Is this a Prorated/Spaced Field? yes  no   
Target Formation(s): Mississippi

Nearest lease or unit boundary: 840-FNL 330 Full  
Ground Surface Elevation: \_\_\_\_\_

Water well within one-quarter mile: yes  no   
Public water supply well within one mile: yes  no

Depth to bottom of fresh water: \_\_\_\_\_  
Depth to bottom of usable water: 180

Surface Pipe by Alternate:  1  2  
Length of Surface Pipe \_\_\_\_\_ set: set 378'

Length of Conductor pipe required: NA  
Projected Total Depth: 4630

Formation at Total Depth: \_\_\_\_\_  
Water Source for Drilling Operations: \_\_\_\_\_

DWR Permit #: \_\_\_\_\_  
Will Cores Be Taken?: yes  no

If yes, proposed zone: \_\_\_\_\_

CONTRACTOR: License # 5929  
Name: Duke Drilling Co., Inc.

Well Drilled For:	Well Class:	Type	Equipment:
<input checked="" type="checkbox"/> Oil	Enh Rec	<input checked="" type="checkbox"/> Infield	<input checked="" type="checkbox"/> Mud Rotary
<input checked="" type="checkbox"/> Gas	Storage	Pool Ext.	Air Rotary
<input checked="" type="checkbox"/> OWD	Disposal	Wildcat	Cable
Seismic:	# of Holes	Other	
Other			

If OWD: old well information as follows:  
Operator: Skelly Oil Co.  
Well Name: Boggs "K"  
Comp. Date: 2/16/56 Old Total Depth 4630

Directional, Deviated or Horizontal wellbore? yes  no   
If yes, true vertical depth: \_\_\_\_\_  
Bottom Hole Location: \_\_\_\_\_

**AFFIDAVIT**

The undersigned hereby affirms that the drilling, completion and eventual plugging of this well will comply with K.S.A. 55 101, et. seq.  
It is agreed that the following minimum requirements will be met:

RECEIVED  
STATE CORPORATION COMMISSION  
MAY 11 1994  
CONSERVATION DIVISION  
Wichita, Kansas

1. Notify the appropriate district office prior to spudding of well;
2. A copy of the approved notice of intent to drill shall be posted on each drilling rig;
3. The minimum amount of surface pipe as specified below shall be set by circulating cement to the top; in all cases surface pipe shall be set through all unconsolidated materials plus a minimum of 20 feet into the underlying formation;
4. If the well is dry hole, an agreement between the operator and the district office on plug length and placement is necessary prior to plugging;
5. The appropriate district office will be notified before well is either plugged or production casing is cemented in;
6. IF AN ALTERNATE II COMPLETION, PRODUCTION PIPE SHALL BE CEMENTED FROM BELOW ANY USABLE WATER TO SURFACE WITHIN 120 DAY OF SPUD DATE. IN ALL CASES, NOTIFY DISTRICT OFFICE PRIOR TO ANY CEMENTING.

I hereby certify that the statements made herein are true and to the best of my knowledge and belief.  
Date: 5/10/94 Signature of Operator or Agent: John S. Weir Title: President

FOR KCC USE:  
API # 15- 007-01039-00-01  
Conductor pipe required NONE feet  
Minimum surface pipe required 378' feet per Alt.   
Approved by: CB 5-11-94

This authorization expires: 11-11-94  
(This authorization void if drilling not started within 6 months of effective date.)  
Spud date: \_\_\_\_\_ Agent: \_\_\_\_\_

REMEMBER TO:

- File Drill Pit Application (form CDP-1) with Intent to Drill;
- File Completion Form ACD-1 within 120 days of spud date;
- File acreage attribution plat according to field proration orders;
- Notify appropriate district office 48 hours prior to workover or re-entry;
- Submit plugging report (CP-4) after plugging is completed;
- Obtain written approval before disposing or injecting salt water.

Mail to: Conservation Division, 200 Colorado Derby Building, 202 W. First St., Wichita, Kansas 67202-1286.

18  
33  
12

IN ALL CASES PLOT THE INTENDED WELL ON THE PLAT BELOW

PLAT OF ACREAGE ATTRIBUTABLE TO A WELL IN A PRORATED OR SPACED FIELD

If the intended well is in a prorated or spaced field, please fully complete this side of the form. If the intended well is in a prorated or spaced field complete the plat below showing that the well will be properly located in relationship to other wells producing from the common source of supply. Please show all the wells within 1 mile of the boundaries of the proposed acreage attribution unit for gas wells and within 1/2 mile of the boundaries of the proposed acreage attribution unit for oil wells.

API NO. 15- \_\_\_\_\_  
 OPERATOR Oil Producers, Inc. of Kansas  
 LEASE Bartholow  
 WELL NUMBER #2  
 FIELD \_\_\_\_\_

LOCATION OF WELL: COUNTY Barber  
840 feet from ~~south~~/north line of section  
990 feet from east/~~west~~ line of section  
 SECTION 18 TWP 33S RG 12W



NUMBER OF ACRES ATTRIBUTABLE TO WELL \_\_\_\_\_  
 QTR/QTR/QTR OF ACREAGE \_\_\_\_\_

IS SECTION X REGULAR or \_\_\_\_\_ IRREGULAR  
IF SECTION IS IRREGULAR, LOCATE WELL FROM NEAREST CORNER BOUNDARY.

Section corner used: \_\_\_\_\_ NE \_\_\_\_\_ NW \_\_\_\_\_ SE \_\_\_\_\_ SW

PLAT

(Show location of the well and shade attributable acreage for prorated or spaced wells.)  
 (Show footage to the nearest lease or unit boundary line.)

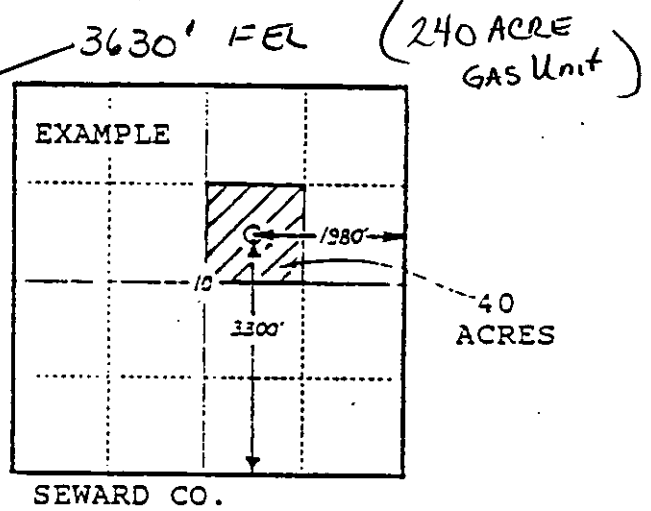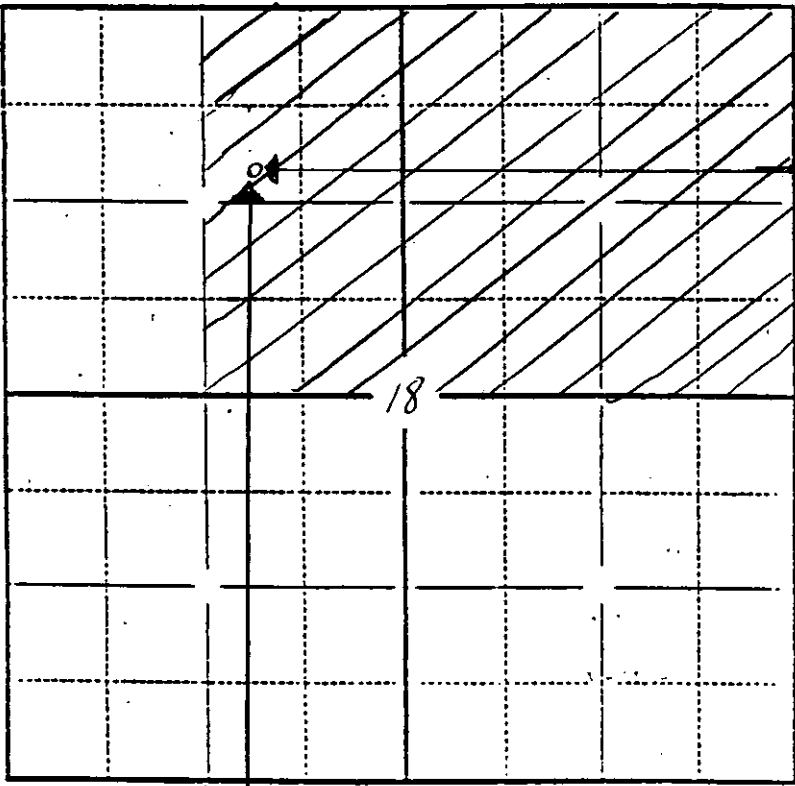

In plotting the proposed location of the well, you must show:

- 1) The manner in which you are using the depicted plat by identifying section lines, i.e. 1 section, 1 section with 8 surrounding sections, 4 sections, etc.;
- 2) the distance of the proposed drilling location from the section's south/north and east/west lines; and
- 3) the distance to the nearest lease or unit boundary line.