

CARD MUST BE TYPED

State of Kansas
NOTICE OF INTENTION TO DRILL
(see rules on reverse side)

CARD MUST BE SIGNED

Starting Date:2-17-85.....
month day year 10:40

OPERATOR: License #5422.....
Name ..Abercrombie Drilling, Inc....
Address ..801 Union Center.....
City/State/Zip ..Wichita, KS 67202.....
Contact Person ..Jack Partridge.....
Phone316-262-1841.....

CONTRACTOR: License #5422.....
NameAbercrombie Drilling, Inc....
City/State ..Wichita, KS 67202.....

Well Drilled For: Well Class: Type Equipment:
 Oil Swd Infield Mud Rotary
 Gas Inj Pool Ext. Air Rotary
 OWWO Expl Wildcat Cable

If OWWO: old well info as follows:
Operator
Well Name
Comp Date Old Total Depth
Projected Total Depth4450..... feet
Projected Formation at TDViola.....
Expected Producing Formations ..Marmaton/Viola.....

API Number 15- 007-22,009-00-00
150' N & 100' W of East
C.E./2.SE/4 Sec. 4.. Twp. 31 S, Rge 15.. West
(location)
...1470..... Ft North from Southeast Corner of Section
...760..... Ft West from Southeast Corner of Section
(Note: Locate well on Section Plat on reverse side)

Nearest lease or unit boundary line760..... feet.
County ...Barber.....
Lease Name ..Lenkner..... Well# 1..(Twin)
Domestic well within 330 feet : yes no
Municipal well within one mile : yes no

Depth to Bottom of fresh water200..... feet
Lowest usable water formation Holdredge Formation
Depth to Bottom of usable water200..... feet
Surface pipe by Alternate : 1 2
Surface pipe to be set850..... feet
Conductor pipe if any required feet
Ground surface elevation1750 (est)..... feet MSL
This Authorization Expires2-15-85.....
Approved By2-15-85.....

I certify that we will comply with K.S.A. 55-101, et seq., plus eventually plugging hole to K.C.C. specifications.


Date2-15-85..... Signature of Operator or Agent *Scott A. Ball* TitleAgent.....
Scott A. Ball

WMC/HOME 2-15-85

Must be filed with the K.C.C. five (5) days prior to commencing well
This card void if drilling not started within six (6) months of date received by K.C.C.

Important procedures to follow :

**A Regular Section of Land
1 Mile = 5,280 Ft.**

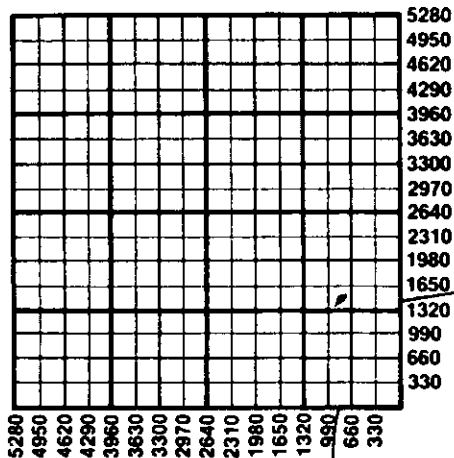

1. Notify District office before setting surface casing.
2. Set surface casing by circulating cement to the top.
3. File completion forms with K.C.C. within 90 days of well completion. **RECEIVED**
WICHITA CONSERVATION COMMISSION
OCT 15 1985
Follow instructions on ACO-1, side 1, and including copies of wireline logs.
4. Notify District office 48 hours before old well workover or re-entry. **RECEIVED**
5. Prior to plugging, prepare a plugging plan, then obtain agreement from the appropriate district office or an approved plugging plan. **RECEIVED**
Wichita, Kansas
6. Submit plugging report (CP-4) to K.C.C. after plugging is completed.
7. Obtain an approved injection docket number before disposing of salt water.
8. Notify K.C.C. within 10 days when injection commences or terminates.
9. If an alternate 2 completion, cement in the production pipe from below any usable water to surface within 120 days of spud date.

State Corporation Commission of Kansas
Conservation Division
200 Colorado Derby Building
Wichita, Kansas 67202
(316) 263-3238