

CARD MUST BE TYPED
CORRECTED COPY

State of Kansas
NOTICE OF INTENTION TO DRILL
(see rules on reverse side)

CARD MUST BE SIGNED
CORRECTED COPY
2-15-85

Starting Date: 2-9-85
month day year

API Number 15-007-12,001-00-00

OPERATOR: License # 5422
Name Abercrombie Drilling, Inc.
Address 801 Union Center
City/State/Zip Wichita, KS 67202
Contact Person Jack Partridge
Phone 316-262-1841

*150. N. C. E. / 2. SE 44. 4. Twp. 31 S. Rge. 15
(location) East West

* 1470 Ft North from Southeast Corner of Section
660 Ft West from Southeast Corner of Section
(Note: Locate well on Section Plat on reverse side)

CONTRACTOR: License # 5422
Name Abercrombie Drilling, Inc.
City/State Wichita, KS

Nearest lease or unit boundary line 660 feet.
County Barber
Lease Name Lenkner Well# 1

Well Drilled For: Well Class: Type Equipment:
 Oil Swd Infield Mud Rotary
 Gas Inj Pool Ext. Air Rotary
 OWWO Expl Wildcat Cable

Domestic well within 330 feet: yes no
Municipal well within one mile: yes no

If OWWO: old well info as follows:

Operator
Well Name
Comp Date Old Total Depth
Projected Total Depth 4450 feet
Projected Formation at TD Viola
Expected Producing Formations Marmaton/Viola

Depth to Bottom of fresh water 200 feet
Lowest usable water formation Holdredge Formation
Depth to Bottom of usable water 200 feet
Surface pipe by Alternate: 1 2
Surface pipe to be set 300 feet
Conductor pipe if any required feet
Ground surface elevation 1750 feet MSL
This Authorization Expires 7-18-85
Approved By 1-18-85


I certify that we will comply with K.S.A. 55-101, et seq., plus eventually plugging hole to K.C.C. specifications. *twas CE/2SE/4 1320 PL*

Date 2-15-85 Signature of Operator or Agent *Scott A. Ball* Title Agent
Scott A. Ball

Must be filed with the K.C.C. five (5) days prior to commencing well
This card void if drilling not started within six (6) months of date received by K.C.C.

Important procedures to follow :

A Regular Section of Land
1 Mile = 5,280 Ft.

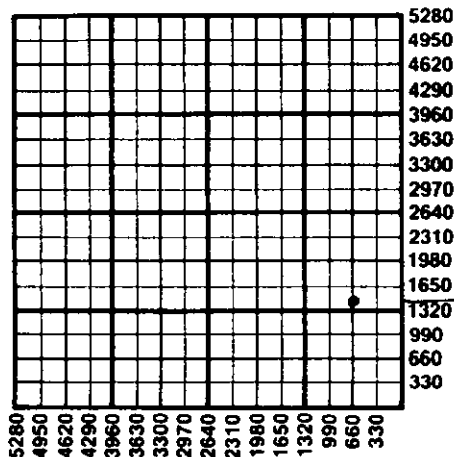

1. Notify District office before setting surface casing.
2. Set surface casing by circulating cement to the top.
3. File completion forms ACO-1 with K.C.C. within 90 days of well completion, following instructions on the back side 1, and including copies of wireline logs.
4. Notify District office 48 hours prior to old well workover or re-entry.
5. Prior to plugging, prepare a plugging plan and obtain agreement from the appropriate district office for an approved plugging plan.
6. Submit plugging report (CP-1) to K.C.C. when plugging is completed.
7. Obtain an approved injection docket number before disposing of salt water.
8. Notify K.C.C. within 10 days when injection commences or terminates.
9. If an alternate 2 completion, cement in the production pipe from below any usable water to surface within 120 days of spud date.

STATE CORPORATION COMMISSION
RECEIVED
FFB 15 1989
STATE CORPORATION COMMISSION
WICHITA, KANSAS

State Corporation Commission of Kansas
Conservation Division
200 Colorado Derby Building
Wichita, Kansas 67202
(316) 263-3238