

E 42 2-15-85

CARD MUST BE TYPED

State of Kansas
NOTICE OF INTENTION TO DRILL
(see rules on reverse side)

CARD MUST BE SIGNED

Starting Date: August 20, 1984
month day year

API Number 15-007-21,903.00.00 *CORRECTION 82704

OPERATOR: License # 5428
Name Graves Drilling Co., Inc.
Address 910 Union Center
City/State/Zip Wichita, KS 67202
Contact Person Betty Brandt
Phone 316 265-7233

* N/2 NW, NE.. Sec 36.. Twp . 31 S, Rge . 15. East West
(location)

* 4950 Ft North from Southeast Corner of Section
* 21980 Ft West from Southeast Corner of Section
(Note: Locate well on Section Plat on reverse side)

CONTRACTOR: License # 5428
Name Graves Drilling Co., Inc.
City/State Wichita, KS 67202

Nearest lease or unit boundary line 990 feet.
County Barber
Lease Name Alexander Well# 2

Domestic well within 330 feet : yes no
Municipal well within one mile : yes no

Well Drilled For: Well Class: Type Equipment:
 Oil Swd Infield Mud Rotary
 Gas Inj Pool Ext. Air Rotary
 OWWO Expl Wildcat Cable

Depth to Bottom of fresh water 60 feet
Lowest usable water formation
Depth to Bottom of usable water 200 feet


If OWWO: old well info as follows:
Operator
Well Name
Comp Date Old Total Depth
Projected Total Depth 5100 feet
Projected Formation at TD ... Arbuckle
Expected Producing Formations Arbuckle

Surface pipe by Alternate : 1 2
Surface pipe to be set 300 feet
Conductor pipe if any required 00 feet
Ground surface elevation 1860 feet MSL
This Authorization Expires 2-15-85
Approved By 8-15-84

I certify that we will comply with K.S.A. 55-101, et seq., plus eventually plugging hole to K.C.C. specifications. * was 5 wellbore
Date 8-27-84 Signature of Operator or Agent *Conrad Grewer* Title Vice-President 4290 FSL 2310 FCL

Must be filed with the K.C.C. five (5) days prior to commencing well
This card void if drilling not started within six (6) months of date received by K.C.C.

RECEIVED
STATE CORPORATION COMMISSION
A Regular Section of Land
1 Mile - 5,280 Ft.
AUG 27 1984

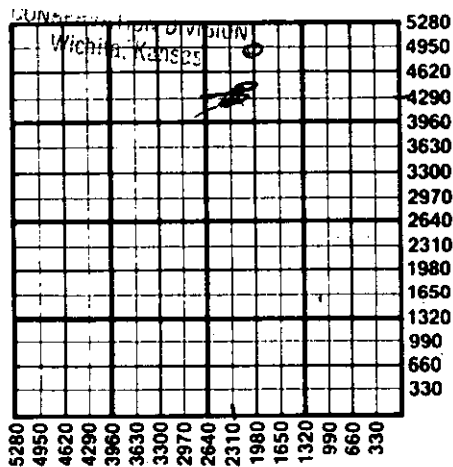

Important procedures to follow:

1. Notify District office before setting surface casing.
2. Set surface casing by circulating cement to the top.
3. File completion forms ACO-1 with K.C.C. within 90 days of well completion, following instructions on ACO-1, side 1, and including copies of wireline logs.
4. Notify District office 48 hours prior to old well workover or re-entry.
5. Prior to plugging, prepare a plugging plan, then obtain agreement from the appropriate district office for an approved plugging plan.
6. Submit plugging report (CP-4) to K.C.C. after plugging is completed.
7. Obtain an approved injection docket number before disposing of salt water.
8. Notify K.C.C. within 10 days when injection commences or terminates.
9. If an alternate 2 completion, cement in the production pipe from below any usable water to surface within 120 days of spud date.

State Corporation Commission of Kansas
Conservation Division
200 Colorado Derby Building
Wichita, Kansas 67202
(316) 263-3238