

CARD MUST BE TYPED

State of Kansas
NOTICE OF INTENTION TO DRILL
(see rules on reverse side)

CARD MUST BE SIGNED

Starting Date: January 1 1985
month day year

API Number 15- 007-21,982-00-00

OPERATOR: License # 7044
Name SABINE CORPORATION
Address 6401 NW Grand Blvd., Suite 500
City/State/Zip Oklahoma City, OK 73116
Contact Person Vince J. Grass
Phone (405) 843-0620

SW SE SE Sec. 16 Twp 30 S, Rge 15 East
(location) West
...330..... Ft North from Southeast Corner of Section
...990..... Ft West from Southeast Corner of Section
(Note: Locate well on Section Plat on reverse side)

CONTRACTOR: License # 5657
Name Slawson Drilling Company
City/State 200 Douglas Blvd., Wichita, KS 67202

Nearest lease or unit boundary line 330 feet.
County Barber
Lease Name FREEMAN Well# 1-16

Well Drilled For: Well Class: Type Equipment:
 Oil Swd Infield Mud Rotary
 Gas Inj Pool Ext. Air Rotary
 OWWO Expl Wildcat Cable

Domestic well within 330 feet: yes no
Municipal well within one mile: yes no

If OWWO: old well info as follows:
Operator
Well Name
Comp Date Old Total Depth
Projected Total Depth 4550..... feet
Projected Formation at TD Viola.....
Expected Producing Formations Mississippi.....

Depth to Bottom of fresh water 280 feet
Lowest usable water formation Dakota? N. Appawalla Group
Depth to Bottom of usable water 500 200 feet
Surface pipe by Alternate: 1 2
Surface pipe to be set 800 feet
Conductor pipe if any required 0 feet
Ground surface elevation 1860 feet MSL.
This Authorization Expires 6-27-85
Approved By RCH/KC 12-27-84

I certify that we will comply with K.S.A. 55-101, et seq., plus eventually plugging hole to K.C.C. specifications.


Date 12/26/84 Signature of Operator or Agent

Vince J. Grass Title Division Area Engineer
Vince J. Grass MHC/KOHE 12/21/84
Form C-1 4/84

Must be filed with the K.C.C. five (5) days prior to commencing well
 This card void if drilling not started within six (6) months of date received by K.C.C.
 CONSERVATION DIVISION
 Wichita, Kansas

DEC 27 1984

A Regular Section of land
 STATE OF KANSAS
 RECEIVED
 1 Mile

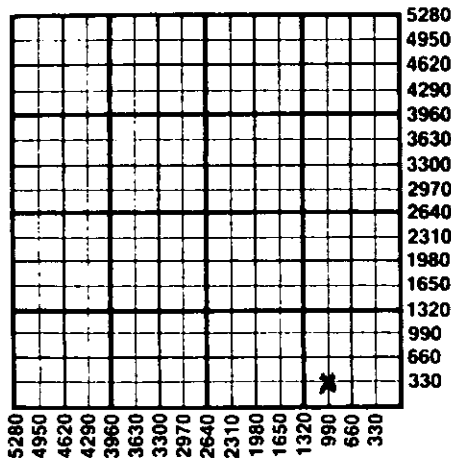

Important procedures to follow :

1. Notify District office before setting surface casing.
2. Set surface casing by circulating cement to the top.
3. File completion forms ACO-1 with K.C.C. within 90 days of well completion, following instructions on ACO-1, side 1, and including copies of wireline logs.
4. Notify District office 48 hours prior to old well workover or re-entry.
5. Prior to plugging, prepare a plugging plan, then obtain agreement from the appropriate district office for an approved plugging plan.
6. Submit plugging report (CP-4) to K.C.C. after plugging is completed.
7. Obtain an approved injection docket number before disposing of salt water.
8. Notify K.C.C. within 10 days when injection commences or terminates.
9. If an alternate 2 completion, cement in the production pipe from below any usable water to surface within 120 days of spud date.

**State Corporation Commission of Kansas
 Conservation Division
 200 Colorado Derby Building
 Wichita, Kansas 67202
 (316) 263-3238**