

Must be approved by the K.C.C. five (5) days prior to commencing well

Expected Spud Date Feb. 25 89
month day year

C: NE-SE Sec 6 Twp 30 S, Rg 15 East
 West

OPERATOR: License # 5673
Name: W. L. Kirkman, Inc.
Address: P.O. Box 782290
City/State/Zip: Wichita, Ks. 67278-2290
Contact Person: Michael Kirkman
Phone: 672-2827-home 672-7471-office

1980' feet from South line of Section
660' feet from East line of Section
(Note: Locate well on Section Plat Below)

CONTRACTOR: License #: unknown
Name: unknown

County: Barber
Lease Name: Lee Trust Well #: 4
Field Name: _____
Is this a Prorated Field? yes no
Target Formation(s): _____
Nearest lease or unit boundary: 660'
Ground Surface Elevation: 1980 feet MSL
Domestic well within 330 feet: yes no
Municipal well within one mile: yes no
Depth to bottom of fresh water: 60'
Depth to bottom of usable water: 180'
Surface Pipe by Alternate: 1 2
Length of Surface Pipe Planned to be set: 250'
Length of Conductor pipe required: none
Projected Total Depth: 4850
Formation at Total Depth: Simpson Sand
Water Source for Drilling Operations:
 well farm pond other

Well Drilled For: Well Class: Type Equipment:
X Oil Inj Infield Mud Rotary
X Gas Storage Pool Ext. Air Rotary
 OWWO Disposal Wildcat Cable
 Seismic; # of Holes

If OWWO: old well information as follows:
Operator: _____
Well Name: _____
Comp. Date: _____ Old Total Depth _____

Directional, Deviated or Horizontal wellbore? yes no
If yes, total depth location: _____

DWR Permit #: _____
Will Cores Be Taken?: yes no
If yes, proposed zone: _____

AFFIDAVIT


The undersigned hereby affirms that the drilling, completion and eventual plugging of this well will comply with K.S.A. 55-101, et. seq.

It is agreed that the following minimum requirements will be met:

1. The appropriate district office shall be notified before setting surface pipe;
2. The minimum amount of surface pipe as specified above shall be set by circulating cement to the top; in all cases surface pipe shall be set through all unconsolidated materials plus a minimum of 20 feet into the underlying formation;
3. If the well is dry, a plugging proposal shall be submitted to the district office. An agreement between the operator and the district office on plug length and placement is necessary prior to plugging;
4. The appropriate district office will be notified before well is either plugged or production casing is cemented in;
5. If an Alternate II completion, production pipe shall be cemented from below any usable water to surface within 120 days of spud date. In all cases, notify district office prior to any cementing.

I hereby certify that the statements made herein are true and to the best of my knowledge and belief.

Date: 2/09/89 Signature of Operator or Agent: Wayne L. Kirkman Title: President

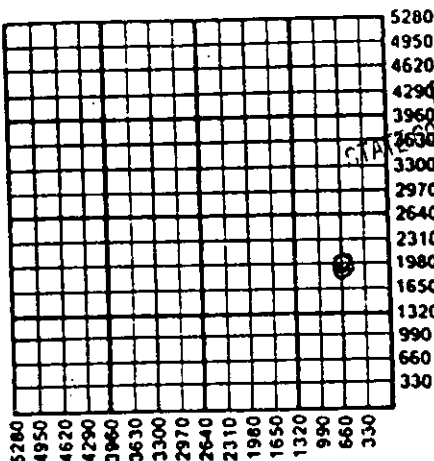

RECEIVED
CORPORATION COMMISSION
FEB 10 1989
CONSERVATION DIVISION
Wichita, Kansas

FOR KCC USE:
API # 15- 007-22,225-00-00
Conductor pipe required 200 feet
Minimum surface pipe required 200 feet per Alt. 1
Approved by: LKM 2-10-89
EFFECTIVE DATE: 2-15-89
This authorization expires: 8-10-89
(This authorization void if drilling not started within 6 months of effective date.)
Spud date: _____ Agent: _____

6
30
15w

- REMEMBER TO:
- File Drill Pit Application (form CDP-1) with Intent to Drill;
 - File Completion Form ACO-1 within 120 days of spud date;
 - File acreage attribution plat according to field prorations orders;
 - Notify appropriate district office 48 hours prior to workover or re-entry;
 - Submit plugging report (CP-4) after plugging is completed;
 - Obtain written approval before disposing or injecting salt water.