

NOTICE OF INTENTION TO DRILL

(see rules on reverse side)

Expected Spud Date... November 5, 1987

API Number 15-165-21394-0000

✓ DA

OPERATOR: License # 6563
Name DOUBLE B!!! OIL, INC.
Address 300 WEST DOUGLAS - SUITE 320
City/State/Zip WICHITA, KS 67202
Contact Person LELAND E. BRACK
Phone 264-2891 - Res, / 685-2393 - Off.

C E/2 NE. SW... Sec 33... Twp. 19.. S, Rg... 16.. X West
1980 Ft. from South Line of Section
2970 Ft. from East Line of Section
(Note: Locate well on Section Plat on reverse side)

CONTRACTOR: License # 5122
Name WOODMAN-IANNITTI OIL CO.
City/State WICHITA, KANSAS

Nearest lease or unit boundary line 1320 feet
County RUSH
Lease Name OETKEN Well # 6

Well Drilled For: Well Class: Type Equipment:
X Oil Storage Infield X Mud Rotary
Gas Inj Pool Ext Air Rotary
OWWO Expl Wildcat Cable

Ground surface elevation UNKNOWN feet MSL
Domestic well within 330 feet: yes X no
Municipal well within one mile: yes X no

If OWWO: old well info as follows:

Operator
Well Name
Comp Date Old Total Depth

Depth to bottom of fresh water 150
Depth to bottom of usable water 200
Surface pipe by Alternate: 1 X 2
Surface pipe planned to be set 985
Conductor pipe required
Projected Total Depth 3800 feet
Formation ARBUCKLE

I certify that well will comply with K.S.A. 55-101, et seq., plus eventually plugging hole to KCC specifications.

Date 10/23/87 Signature of Operator or Agent Leland E. Brack Title PRESIDENT

For KCC Use:

Conductor Pipe Required 320 feet; Minimum Surface Pipe Required 320 feet per Alt. OX
This Authorization Expires 5-8-88 Approved By DQ 11-4-87


EFFECTIVE DATE: 11-9-87

Must be filed with the K.C.C. five (5) days prior to commencing well  
This card void if drilling not started within six (6) months of date received by K.C.C.

Important procedures to follow:

1. Notify District office before setting surface casing.
2. Set surface casing by circulating cement to the top.
3. File completion forms ACO-1 with K.C.C. within 120 days of well spud date, following instructions on ACO-1, side 1, and including copies of wireline logs.
4. Notify District office 48 hours prior to old well workover or re-entry.
5. Prior to filing Intent, prepare a proposed plugging plan in case well is D & A, then obtain approval of plan when calling district office prior to setting surface pipe.
6. Submit plugging report (CP-4) to K.C.C. after plugging is completed.
7. Obtain an approved injection docket number before disposing of salt water.
8. Notify K.C.C. within 10 days when injection commences or terminates.
9. If an alternate 2 completion, cement in the production pipe from below any usable water to surface within 120 days of spud date.

A Regular Section of Land  
1 Mile = 5,280 Ft.

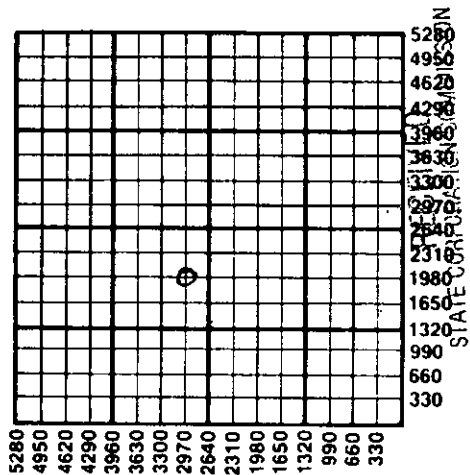

OCT 30 1987  
10-30-87  
CONSERVATION DIVISION  
Wichita, Kansas

State Corporation Commission of Kansas  
Conservation Division  
200 Colorado Derby Building  
Wichita, Kansas 67202-1212  
(316) 263-3238