

CARD MUST BE TYPED

State of Kansas  
**NOTICE OF INTENTION TO DRILL**  
(see rules on reverse side)

CARD MUST BE SIGNED

Starting Date: November 5, 1984  
month day year

API Number 15- 007-21,956-00-00

OPERATOR: License # 5428  
Name Graves Drilling Co., Inc.  
Address 910 Union Center  
City/State/Zip Wichita, Kansas 67202  
Contact Person Betty Brandt  
Phone 316 265-7233

SW SE NW Sec 2 Twp 32 S. Rge 12  East  
(location)  West  
2970 Ft North from Southeast Corner of Section  
3630 Ft West from Southeast Corner of Section  
(Note: Locate well on Section Plat on reverse side)

CONTRACTOR: License # 5428  
Name Graves Drilling Co., Inc.  
City/State Wichita, Kansas 67202

Nearest lease or unit boundary line 330 feet.  
County Barber  
Lease Name Dawson-Gress Well# 1  
Domestic well within 330 feet:  yes  no  
Municipal well within one mile:  yes  no

Well Drilled For: Well Class: Type Equipment:  
 Oil  Swd  Infield  Mud Rotary  
 Gas  Inj  Pool Ext.  Air Rotary  
 OWWO  Expl  Wildcat  Cable

Depth to Bottom of fresh water 60 25 mhc feet  
Lowest usable water formation ..... feet  
Depth to Bottom of usable water 200 feet  
Surface pipe by Alternate: 1  2   
Surface pipe to be set 360 feet  
Conductor pipe if any required 0 feet  
Ground surface elevation 1514 feet MSL.  
This Authorization Expires 7-29-85  
Approved By 10-29-84 *Rc*

If OWWO: old well info as follows:  
Operator .....  
Well Name .....  
Comp Date ..... Old Total Depth .....  
Projected Total Depth 4350 feet  
Projected Formation at TD Mississippian  
Expected Producing Formations Mississippian

I certify that we will comply with K.S.A. 55-101, et seq., plus eventually plugging hole to K.C.C. specifications.

Date D-26-84 Signature of Operator or Agent *Betty Brandt*


Title Sec.-Treas. Form C-1 4/84

*mhc/KDHE 10/29/84*

Must be filed with the K.C.C. five (5) days prior to commencing well  
This card void if drilling not started within six (6) months of date received by K.C.C.

**Important procedures to follow:**

**A Regular Section of Land  
1 Mile = 5,280 Ft.**

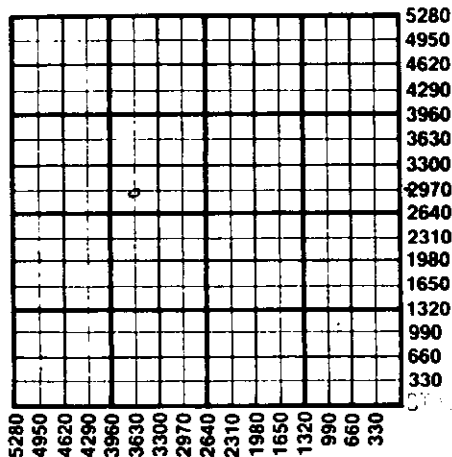

1. Notify District office before setting surface casing.
2. Set surface casing by circulating cement to the top.
3. File completion forms ACO-1 with K.C.C. within 90 days of well completion, following instructions on ACO-1, side 1, and including copies of wireline logs.
4. Notify District office 48 hours prior to old well workover or re-entry.
5. Prior to plugging, prepare a plugging plan, then obtain agreement from the appropriate district office for an approved plugging plan.
6. Submit plugging report (CP-4) to K.C.C. after plugging is completed.
7. Obtain an approved injection docket number before disposing of salt water.
8. Notify K.C.C. within 10 days when injection commences or terminates.
9. If an alternate 2 completion, cement in the production pipe from below any usable water to surface within 120 days of spud date.

State Corporation Commission of Kansas  
Conservation Division  
200 Colorado Derby Building  
Wichita, Kansas 67202  
(316) 263-3238

NOV 29 1984  
10-29-84  
Conservation Division  
Wichita