

CARD MUST BE TYPED

A

State of Kansas

CARD MUST BE SIGNED

NOTICE OF INTENTION TO DRILL

(see rules on reverse side)

-00-01

Starting Date July 16 86
month day year *405*

API Number 15— *077-26119-A* _____ East

OPERATOR: License # 9533

.NE .SW .NW Sec. 8.... Twp. 32. S, Rg. 8.... West

Name Fairchild Exploration Inc.

Address R. R. 3

City/State/Zip Kingman, Kansas 67068

Contact Person Bob G. Fairchild

Phone 316-532-3047

..... 3630 Ft. from South Line of Section

..... 4290 Ft. from East Line of Section

(Note: Locate well on Section Plat on reverse side)

Nearest lease or unit boundary line 680 feet

County Harper

Lease Name... Rector #1 Well #... 1

Ground surface elevation 1506 feet MSL

Domestic well within 330 feet: _____yes no

Municipal well within one mile: _____yes no

Depth to bottom of fresh water.....

Depth to bottom of usable water *200*

Surface pipe by Alternate: 1 2 _____

Surface pipe ~~planned~~ set *260*

Conductor pipe required

Projected Total Depth 4500 feet

Formation Miss.

CONTRACTOR: License # 5842

Name Gabbert-Jones *Inc*

City/State Wichita, Kansas

Well Drilled For: Well Class: Type Equipment:

Oil _____ SWD _____ Infield Mud Rotary

_____ Gas _____ Inj _____ Pool Ext. _____ Air Rotary

OWWO _____ Expl Wildcat _____ Cable

If OWWO: old well info as follows:

Operator Resource Ventures Corporation

Well Name Rector No. 1-8

Comp Date .. Dec. 11, 85 Old Total Depth... 4500

I certify that well will comply with K.S.A. 55-101, et seq., plus eventually plugging hole to KCC specifications.

Date .. July 14, 86 Signature of Operator or Agent *Bob G. Fairchild* Title... *Operator*

For KCC Use:

Conductor Pipe Required feet: Minimum Surface Pipe Required

This Authorization Expires *1-14-87*

..... *20* feet per Alt *1*


Approved By *7-14-86*

Must be filed with the K.C.C. five (5) days prior to commencing well
This card void if drilling not started within six (6) months of date received by K.C.C.

Important procedures to follow:

1. Notify District office before setting surface casing.
2. Set surface casing by circulating cement to the top.
3. File completion forms ACO-1 with K.C.C. within 90 days of well completion, following instructions on ACO-1, side 1, and including copies of wireline logs.
4. Notify District office 48 hours prior to old well workover or re-entry.
5. Prior to filing Intent, prepare a proposed plugging plan in case well is D & A, then obtain approval of plan when calling district office prior to setting surface pipe.
6. Submit plugging report (CP-4) to K.C.C. after plugging is completed.
7. Obtain an approved injection docket number before disposing of salt water.
8. Notify K.C.C. within 10 days when injection commences or terminates.

A Regular Section of Land 1 Mile = 5,280 Ft.

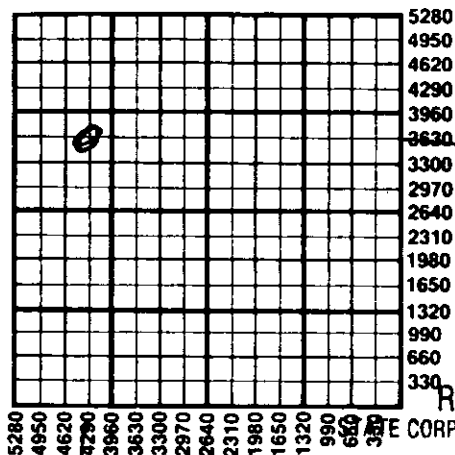

RECEIVED

STATE CORPORATION COMMISSION

JUL 14 1986

CONSERVATION DIVISION
Wichita, Kansas

9. If an alternate 2 completion, cement in the production pipe from below any usable water to surface within 120 days of spud date.

State Corporation Commission of Kansas
Conservation Division
200 Colorado Derby Building
Wichita, Kansas 67202
(316) 263-3238