

FOR KCC USE:

FORM C-1 7/91

EFFECTIVE DATE: 6-21-92

FORM MUST BE TYPED

DISTRICT # 1

State of Kansas

FORM MUST BE SIGNED

SGA7.  Yes...  No

NOTICE OF INTENTION TO DRILL

ALL BLANKS MUST BE FILLED

Must be approved by the K.C.C. five (5) days prior to commencing well

Expected Spud Date June 17 1991  
month day year

Spot 50' South  
 W/2-NE SW Sec 10 Twp 30 S, Rg 15 East  
 West

OPERATOR: License # 5030 ✓  
Name: Vess Oil Corporation  
Address: 8100 E. 22nd Street N., Bldg. 300  
City/State/Zip: Wichita, KS 67226  
Contact Person: W. R. Horigan  
Phone: 316-682-1537

✓1930 ..... feet from South / North line of Section  
✓3630 ..... feet from East / West line of Section

IS SECTION  REGULAR  IRREGULAR?  
(NOTE: Locate well on the Section Plat on Reverse Side)

CONTRACTOR: License # 3641 ✓  
Name: Saturn Well Service

County: Barber  
Lease Name: Brickey Well # 1  
Field Name: Wildcat Moffett

Well Drilled For: Well Class: Type Equipment:

Is this a Prorated/Spaced Field? ... yes  no  
Target Formation(s): Douglas Sand

- Oil ... Enh Rec ... Infield ... Mud Rotary
- Gas ... Storage ... Pool Ext. ... Air Rotary
- OWWD ... Disposal ... Wildcat ... Cable
- Seismic; ... # of Holes ... Other
- Other

Nearest lease or unit boundary: 330'  
Ground Surface Elevation: 1979 feet MSL

If OWWD: old well information as follows:

Water well within one-quarter mile: ... yes  no

Operator: Gear Petroleum  
Well Name: Brickey A #1  
Comp. Date: 9/13/80 Old Total Depth 4730'

Public water supply well within one mile: ... yes  no  
Depth to bottom of fresh water: 115

Directional, Deviated or Horizontal wellbore? ... yes  no

Depth to bottom of usable water: 180  
Surface Pipe by Alternate:  1 ... 2

If yes, true vertical depth: .....

Length of Surface Pipe Planned to be set: 1043'  
Length of Conductor pipe required: None

Bottom Hole Location: .....

Projected Total Depth: 4150  
Formation at Total Depth: KC

Water Source for Drilling Operations:  
... well ... farm pond  other

AFFIDAVIT

The undersigned hereby affirms that the drilling, completion and eventual plugging of this well will comply with K.S.A. 55-101, et. seq.

It is agreed that the following minimum requirements will be met:

1. Notify the appropriate district office prior to spudding of well;
2. A copy of the approved notice of intent to drill shall be posted on each drilling rig;
3. The minimum amount of surface pipe as specified below shall be set by circulating cement to the top; in all cases surface pipe shall be set through all unconsolidated materials plus a minimum of 20 feet into the underlying formation;
4. If the well is dry hole, an agreement between the operator and the district office on plug length and placement is necessary prior to plugging;
5. The appropriate district office will be notified before well is either plugged or production casing is cemented in;
6. IF AN ALTERNATE II COMPLETION, PRODUCTION PIPE SHALL BE CEMENTED FROM BELOW ANY USABLE WATER TO SURFACE WITHIN 120 DAYS OF SPUD DATE. IN ALL CASES, NOTIFY DISTRICT OFFICE PRIOR TO ANY CEMENTING.

I hereby certify that the statements made herein are true and to the best of my knowledge and belief.

Date: 6/11/92 Signature of Operator or Agent: W. R. Horigan Title: Operations Manager

FOR KCC USE:  
 API # 15- 007-20992-0001  
 Conductor pipe required None feet  
 Minimum surface pipe required 1034 feet per Alt.  K  
 Approved by: C.B. 6-16-92  
 This authorization expires: 12-16-92  
 (This authorization void if drilling not started within 6 months of effective date.)  
 Spud date: \_\_\_\_\_ Agent: \_\_\_\_\_

REMEMBER TO:

- File Drill Pit Application (form CDP-1) with Intent to Drill;
- File Completion Form ACO-1 within 120 days of spud date;
- File acreage attribution plat according to field prorotation orders;
- Notify appropriate district office 48 hours prior to workover or re-entry;
- Submit plugging report (CP-4) after plugging is completed;
- Obtain written approval before disposing or injecting salt water.

Mail to: Conservation Division, 200 Colorado Derby Building, 202 W. First St., Wichita, Kansas 67202-1286.

RECEIVED STATE CORPORATION COMMISSION

JUN 12 1992

CONSERVATION DIVISION  
Wichita, Kansas

10

15

IN ALL CASES PLOT THE INTENDED WELL ON THE PLAT BELOW

PLAT OF ACREAGE ATTRIBUTABLE TO A WELL IN A PRORATED OR SPACED FIELD

If the intended well is in a prorated or spaced field, please fully complete this side of the form. If the intended well is in a prorated or spaced field complete the plat below showing that the well will be properly located in relationship to other wells producing from the common source of supply. Please show all the wells within 1 mile of the boundaries of the proposed acreage attribution unit for gas wells and within 1/2 mile of the boundaries of the proposed acreage attribution unit for oil wells.

API NO. 15- \_\_\_\_\_  
 OPERATOR \_\_\_\_\_  
 LEASE \_\_\_\_\_  
 WELL NUMBER \_\_\_\_\_  
 FIELD \_\_\_\_\_

LOCATION OF WELL: COUNTY \_\_\_\_\_  
 \_\_\_\_\_ feet from south/north line of section  
 \_\_\_\_\_ feet from east/west line of section  
 SECTION \_\_\_\_\_ TWP \_\_\_\_\_ RG \_\_\_\_\_



NUMBER OF ACRES ATTRIBUTABLE TO WELL \_\_\_\_\_  
 QTR/QTR/QTR OF ACREAGE \_\_\_\_\_

IS SECTION \_\_\_\_\_ REGULAR or \_\_\_\_\_ IRREGULAR  
IF SECTION IS IRREGULAR, LOCATE WELL FROM NEAREST CORNER BOUNDARY.

Section corner used: \_\_\_\_\_ NE \_\_\_\_\_ NW \_\_\_\_\_ SE \_\_\_\_\_ SW

PLAT

(Show location of the well and shade attributable acreage for prorated or spaced wells.)  
 (Show footage to the nearest lease or unit boundary line.)

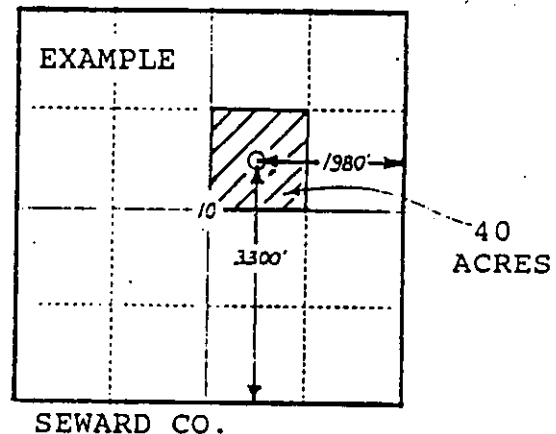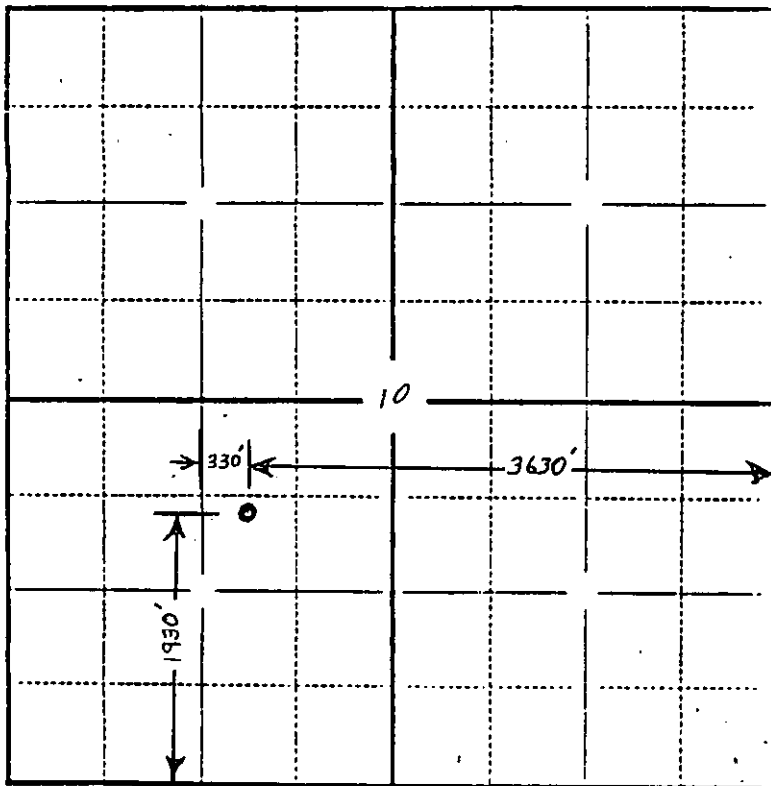

In plotting the proposed location of the well, you must show:

- 1) The manner in which you are using the depicted plat by identifying section lines, i.e. 1 section, 1 section with 8 surrounding sections, 4 sections, etc.;
- 2) the distance of the proposed drilling location from the section's south/north and east/west lines; and
- 3) the distance to the nearest lease or unit boundary line.