

CARD MUST BE TYPED

State of Kansas
NOTICE OF INTENTION TO DRILL

CARD MUST BE SIGNED

(see rules on reverse side)

Starting Date: 5-16-85
month day year

API Number 15- 007-22,044-00-00

OPERATOR: License # 5422
Name .. Abercrombie Drilling, Inc.
Address .. 801 Union Center
City/State/Zip .. Wichita, KS 67202
Contact Person .. Jack L. Partridge
Phone 316-262-1841

Approx. SW. NE. NE 1/4 Sec 5 .. Twp 31S, Rge 15E .. East
(location) West

CONTRACTOR: License # 5422
Name .. Abercrombie Drilling, Inc.
City/State .. Wichita, KS

..... 4210 Ft North from Southeast Corner of Section
..... 830 Ft West from Southeast Corner of Section
(Note: Locate well on Section Plat on reverse slide)

Well Drilled For: Well Class: Type Equipment:
 Oil Swd Infield Mud Rotary
 Gas Inj Pool Ext. Air Rotary
 OWWO Expl Wildcat Cable

Nearest lease or unit boundary line 830 feet.
County .. Barber
Lease Name .. Lenkner "B" Well# 1

If OWWO: old well info as follows:
Operator
Well Name
Comp Date Old Total Depth
Projected Total Depth 4700 feet
Projected Formation at TD Viola
Expected Producing Formations .. Viola-Marmaton

Domestic well within 330 feet : yes no
Municipal well within one mile : yes no
Depth to Bottom of fresh water 200 feet
Lowest usable water formation .. Holdredge Formation ..
Depth to Bottom of usable water 200 feet
Surface pipe by Alternate : 1 2
Surface pipe to be set 970 feet
Conductor pipe if any required feet
Ground surface elevation 1827 feet MSL
This Authorization Expires 11-10-85
Approved By 5-10-85 *RE*

I certify that we will comply with K.S.A. 55-101, et seq., plus eventually plugging holes to K.C.C. specifications.

Date 5-9-85 Signature of Operator or Agent

Jerry A. Langrehr
Jerry A. Langrehr


MHC/UMHE 5-10-85
Exec. V.P. Abercrombie
Drilling

Must be filed with the K.C.C. five (5) days prior to commencing well
This card void if drilling not started within six (6) months of date received by K.C.C.

RECEIVED
STATE CORPORATION COMMISSION

A Regular Section of Land
1 Mile = 5,280 Ft.

MAY 10 1985
CONSERVATION DIVISION
Wichita, Kansas

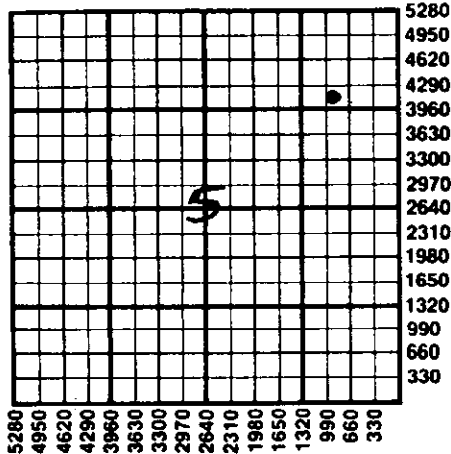

Important procedures to follow:

1. Notify District office before setting surface casing.
2. Set surface casing by circulating cement to the top.
3. File completion forms ACO-1 with K.C.C. within 90 days of well completion, following instructions on ACO-1, side 1, and including copies of wireline logs.
4. Notify District office 48 hours prior to old well workover or re-entry.
5. Prior to plugging, prepare a plugging plan, then obtain agreement from the appropriate district office for an approved plugging plan.
6. Submit plugging report (CP-4) to K.C.C. after plugging is completed.
7. Obtain an approved injection docket number before disposing of salt water.
8. Notify K.C.C. within 10 days when injection commences or terminates.
9. If an alternate 2 completion, cement in the production pipe from below any usable water to surface within 120 days of spud date.

State Corporation Commission of Kansas
Conservation Division
200 Colorado Derby Building
Wichita, Kansas 67202
(316) 263-3238