

CARD MUST BE TYPED

State of Kansas
NOTICE OF INTENTION TO DRILL
(see rules on reverse side)

CARD MUST BE SIGNED

Starting Date: 11-20-85
month day year

API Number 15- 007-22101-00-00

OPERATOR: License # 5428

C SW/4 (location) Sec 11 Twp 32 S, Rge 12. East West

Name Graves Drilling Co., Inc.

Address 910 Union Center

City/State/Zip Wichita, KS 67202

Contact Person Karen Seiler

Phone 316-265-7233

1320 Ft North from Southeast Corner of Section
3960 Ft West from Southeast Corner of Section
(Note: Locate well on Section Plat on reverse side)

CONTRACTOR: License # 5428

Nearest lease or unit boundary line 660 feet.

Name Company Tools

County Barber

City/State

Lease Name Garten Well# 4

Well Drilled For: Well Class: Type Equipment:

- Oil Swd Infield Mud Rotary
- Gas Inj Pool Ext. Air Rotary
- OWWO Expl Wildcat Cable

Domestic well within 330 feet: yes no

Municipal well within one mile: yes no

If OWWO: old well info as follows:

Depth to Bottom of fresh water 60 feet

Lowest usable water formation Permian

Depth to Bottom of usable water 200 feet

Surface pipe by Alternate: 1 2

Surface pipe to be set 374 feet

Conductor pipe if any required None feet

Ground surface elevation 1458 feet MSL

This Authorization Expires 5-6-86

Approved By 11-6-85

Operator

Well Name

Comp Date Old Total Depth

Projected Total Depth 4350 feet

Projected Formation at TD Mississippi

Expected Producing Formations Mississippi

I certify that we will comply with K.S.A. 55-101, et seq., plus eventually plugging hole to K.C.C. specifications.

Date 11-5-85 Signature of Operator or Agent


Karen Seiler

Title Land Secretary *RCH/KDH/E*

Must be filed with the K.C.C. five (5) days prior to commencing well
This card void if drilling not started within six (6) months of date received by K.C.C.

Important procedures to follow :

**A Regular Section of Land
1 Mile = 5,280 Ft.**

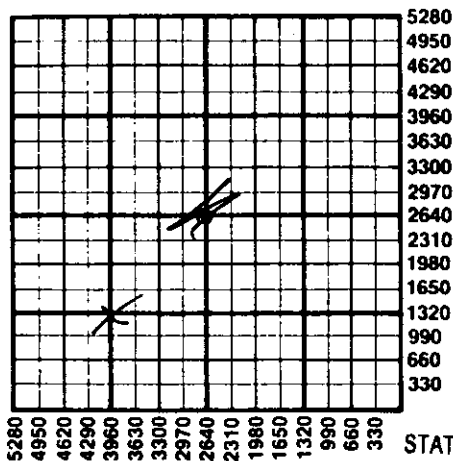

1. Notify District office before setting surface casing.
2. Set surface casing by circulating cement to the top.
3. File completion forms ACO-1 with K.C.C. within 90 days of well completion, following instructions on ACO-1, side 1, and including copies of wireline logs.
4. Notify District office 48 hours prior to old well workover or re-entry.
5. Prior to plugging, prepare a plugging plan, then obtain agreement from the appropriate district office for an approved plugging plan.
6. Submit plugging report (CP-4) to K.C.C. after plugging is completed.
7. Obtain an approved injection docket number before disposing of salt water.
8. Notify K.C.C. within 10 days when injection commences or terminates.
9. If an alternate 2 completion, cement in the production pipe from below any usable water to surface within 120 days of spud date.

RECEIVED

STATE CORPORATION COMMISSION State Corporation Commission of Kansas
Conservation Division

200 Colorado Derby Building
Wichita, Kansas 67202
(316) 263-3238

NOV 6 1985
11-6-85

CONSERVATION DIVISION
Wichita, Kansas