


STATE OF KANSAS  
STATE CORPORATION COMMISSION  
CONSERVATION DIVISION  
P. O. BOX 17027  
WICHITA, KANSAS 67217

FORM CP-4

## WELL PLUGGING RECORD

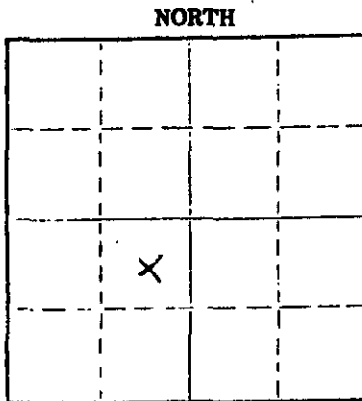

Locate well correctly on above  
Section Plat

Barber County. Sec. 7 Twp. 34 Rge. 11 (E) W (W)  
Location as "NE/CNW/SW" or footage from lines C NE SW  
Lease Owner Kansas Oil & Gas Co., Inc.  
Lease Name Michel Well No. 1-7  
Office Address Chapin Building ; Medicine Lodge, Ks. 67104  
Character of Well (completed as Oil, Gas or Dry Hole) \_\_\_\_\_  
Date well completed \_\_\_\_\_ 19\_\_\_\_  
Application for plugging filed February 1975  
Application for plugging approved February 1975  
Plugging commenced March 1975  
Plugging completed March 30 1975  
Reason for abandonment of well or producing formation \_\_\_\_\_

If a producing well is abandoned, date of last production \_\_\_\_\_ 19\_\_\_\_  
Was permission obtained from the Conservation Division or its agents before plugging was commenced? Yes

Name of Conservation Agent who supervised plugging of this well Russell Biberstein  
Producing formation \_\_\_\_\_ Depth to top \_\_\_\_\_ Bottom \_\_\_\_\_ Total Depth of Well \_\_\_\_\_ Feet  
Show depth and thickness of all water, oil and gas formations.

## OIL, GAS OR WATER RECORDS

## CASING RECORD

FORMATION	CONTENT	FROM	TO	SIZE	PUT IN	PULLED OUT
				8 5/8"	863	None
				4 1/2"	4800	3648

Describe in detail the manner in which the well was plugged, indicating where the mud fluid was placed and the method or methods used in introducing it into the hole. If cement or other plugs were used, state the character of same and depth placed, from \_\_\_\_\_ feet to \_\_\_\_\_ feet for each plug set.

March 1975 Plugged off bottom. Dumped sand to 4200'. Mixed and dumped 4 sx of cement.

March 30, 1975 Plugged off top. Set 10' rock bridge at 350'. Filled 8 5/8" surface casing from 350' to base of cellar with 3000 lb. P.S.I. ready-mix concrete.

(If additional description is necessary, use BACK of this sheet)

Name of Plugging Contractor RUSS CASING PULLING, INC.  
Address P. O. Box 1082 ; Great Bend, Kansas 67530

STATE OF KANSAS COUNTY OF BARBER ss.

Gordon Penny

(employee of owner) or (owner) of the above-described

well, being first duly sworn on oath, says: That I have knowledge of the facts, statements, and matters herein contained and the log of the above-described well as filed and that the same are true and correct. So help me God.


(Signature) \_\_\_\_\_

\_\_\_\_\_  
(Address)

Subscribed and Sworn to before me this 23rd day of August, 1975

\_\_\_\_\_  
Notary Public.

My commission expires \_\_\_\_\_

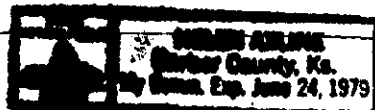

RECEIVED  
STATE CORPORATION COMMISSION

AUG 25 1975

CONSERVATION DIVISION  
Wichita, Kansas