


STATE OF KANSAS
STATE CORPORATION COMMISSION

WELL PLUGGING RECORD

Give All Information Completely
Make Required Affidavit
Mail or Deliver Report to
Conservation Division
State Corporation Comm.
245 North Water
Wichita, KS 67202

Barber County, Sec. 4 Twp. 34S Rge. 11W E/W
Location as "NE/CNW $\frac{1}{4}$ SW $\frac{1}{4}$ " or footage from lines
C NE SW

Lease Owner D. R. Lauck Oil Company, Inc.
Lease Name Slover Well No. 1
Office Address 221 S. Broadway, Suite 400, Wichita, KS 67202
Character of Well (Completed as Oil, Gas or Dry Hole) Dry Hole

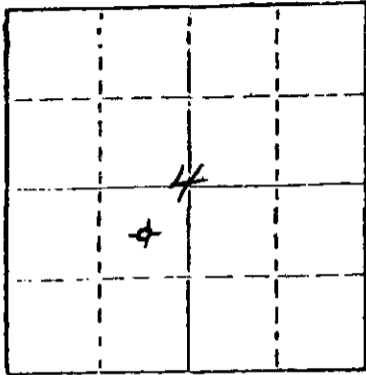

Locate well correctly on above
Section Plat

Date Well completed April 19, 1981
Application for plugging filed April 19, 1981
Application for plugging approved April 19, 1981
Plugging commenced April 19, 1981
Plugging completed April 19, 1981
Reason for abandonment of well or producing formation Dry Hole

If a producing well is abandoned, date of last production 19

Was permission obtained from the Conservation Division or its agents before plugging was commenced? Yes

Name of Conservation Agent who supervised plugging of this well Wm. T. Owen
Producing formation _____ Depth to top _____ Bottom _____ Total Depth of Well 4650'
Show depth and thickness of all water, oil and gas formations.

OIL, GAS OR WATER RECORDS

CASING RECORD

FORMATION	CONTENT	FROM	TO	SIZE	PUT IN	PULLED OUT
		0'	322'	8-5/8"	315.82'	None

Describe in detail the manner in which the well was plugged, indicating where the mud fluid was placed and the method or methods used in introducing it into the hold. If cement or other plugs were used, state the character of same and depth placed, from _____ feet to _____ feet for each plug set.

Plugged with 40 sacks cement at 320';
10 sacks cement and bridge plug at 40';
and 10 sacks cement in rat hole.

(If additional description is necessary, use BACK of this sheet)

Name of Plugging Contractor Allied Cementing Co.

STATE OF KANSAS COUNTY OF SEDGWICK, ss.
John D. Knightley (employee of owner) or (owner or operator)
of the above-described well, being first duly sworn on oath, says: That I have knowledge of the facts, statements, and matters herein contained and the log of the above-described well as filed and that the same are true and correct. So help me God.

(Signature) [Signature]
221 S. Broadway, Suite 400, Wichita, KS 67202
(Address)

SUBSCRIBED AND SWORN TO before me this 6th day of May, 1981

[Signature]
Notary Public.

My commission expires March 12, 1983

D. R. Lauck Oil Company, Inc. - Slover #1
221 S. Broadway, Suite 400 C NE SW Sec. 4-34S-11W
Wichita, Kansas 67202 Barber County, Kansas

Contractor: D. R. Lauck Oil Company, Inc.
221 S. Broadway, Suite 400
Wichita, Kansas 67202

Commenced: April 10, 1981
Completed: April 19, 1981

Drillers Log

Clay, Sand & Shale	325
Red Bed & Shale	1240
Shale & Shells	1675
Shale	2465
Shale & Lime	3750
Lime & Shale	4235
Lime	4650 RTD