


Give All Information Completely  
Make Required Affidavit  
Mail or Deliver Report to:  
Conservation Division  
State Corporation Commission  
211 No. Broadway  
Wichita, Kansas

WELL PLUGGING RECORD

NORTH

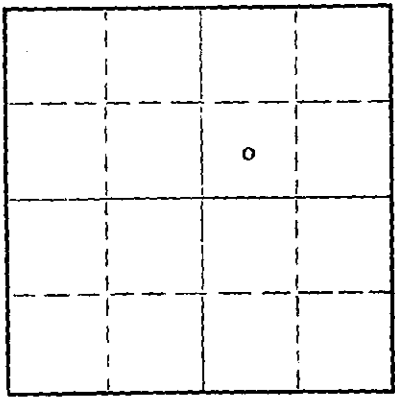

Locate well correctly on above Section Plat

Barber County, Sec. 26 Twp. 34S Rge. 11W (E) (W)  
Location as "NE/CNW/SW" or footage from lines c SW NE

Lease Owner Roy D. McAninch  
Lease Name Dorothy Well No. 1  
Office Address 1363 First National Bldg., Oklahoma City, Okla. 73102

Character of Well (completed as Oil, Gas or Dry Hole) Dry Hole  
Date well completed July 14 19 66  
Application for plugging filed July 14 19 66  
Application for plugging approved July 14 19 66  
Plugging commenced July 14 19 66  
Plugging completed July 14 19 66  
Reason for abandonment of well or producing formation Dry Hole

If a producing well is abandoned, date of last production 19  
Was permission obtained from the Conservation Division or its agents before plugging was commenced? Yes

Name of Conservation Agent who supervised plugging of this well Archie V. Elving, Pratt, Kansas  
Producing formation Depth to top Bottom Total Depth of Well 4690 Feet  
Show depth and thickness of all water, oil and gas formations.

OIL, GAS OR WATER RECORDS

CASING RECORD

FORMATION	CONTENT	FROM	TO	SIZE	PUT IN	PULLED OUT
		0	301'	8 5/8"	301'	None

Describe in detail the manner in which the well was plugged, indicating where the mud fluid was placed and the method or methods used in introducing it into the hole. If cement or other plugs were used, state the character of same and depth placed, from feet to feet for each plug set.

Set Plug: 275'/25 sacks cement  
40'/10 sacks cement  
5 sacks cement in rathole

RECEIVED  
STATE CORPORATION COMMISSION  
JUL 20 1966

(If additional description is necessary, use BACK of this sheet)

Name of Plugging Contractor Hellar Drilling Company, Inc.  
Address 1014 Union Center, Wichita, Kansas 67202

STATE OF Kansas COUNTY OF Sedgwick, ss.  
D. L. Hellar, President of Hellar Drilling Co., Inc. (employee of owner) or (owner or operator) of the above-described well, being first duly sworn on oath, says: That I have knowledge of the facts, statements, and matters herein contained and the log of the above-described well as filed and that the same are true and correct. So help me God.

(Signature) D. L. Hellar, President  
1014 Union Center, Wichita, Kansas 67202  
(Address)

SUBSCRIBED AND SWORN TO before me this 18th day of July, 1966

My commission expires March 25, 1968.

Catherine Darcey  
Catherine Darcey - Notary Public.

DRILLER'S LOG

COMPANY: Roy D. McAninch, 1363 1st Natl. Bldg. Oklahoma City, Okla.  
CONTRACTOR: Hellar Drilling Company, Inc., Wichita, Kansas  
LEASE: #1 Dorothy  
LOCATION: c SW NE 26-34S-11W, Barber County, Kansas  
COMMENCED: July 1, 1966  
COMPLETED: July 14, 1966  
CASING: Set 8 5/8" surface casing @ 301'/275 sacks cement

---

---

0-131	Surface soil, sand & shale
131-301	Shale & Red Beds
301-1273	Shale & Red Beds & shells
1273-1515	Shale & streaks Anhydrite & salt
1515-1790	Salt Section
1790-1925	Shale & Lime
1925-2075	Lime & Shale
2075-2355	Shale & Lime
2355-2494	Lime & Shale
2494-3640	Shale & Lime
3640-3795	Shale & Sandy Lime
3795-3925	Shale & Lime
3925-4065	Shale, Sand & Lime
4065-4237	Shale & Lime
4237-4337	Lime
4337-4390	L. K.C. (cherty)
4390-4542	Lime
4542-4599	Lime & Shale
4599-4670	Shale
4670-4690	Lime & shert
4690	Rotary Total Depth

D & A

---

---

STATE OF KANSAS     )  
                          ) SS  
COUNTY OF SEDGWICK )

I, D. L. Hellar, do hereby certify that the above and foregoing is a true and correct copy of the log of the #1 Dorothy, located in c SW NE Sec. 26-34S-11W, Barber County, Kansas, as reflected by the files of the Hellar Drilling Company, Inc.

HELLAR DRILLING COMPANY, INC.

By *D. L. Hellar*  
President - D. L. Hellar

Subscribed and sworn to before me, a Notary Public, in and for Sedgwick County, Kansas, this 18th day of July, 1966.

My Commission Expires:  
March 25, 1968.

*Catherine Darcy*  
Notary Public - Catherine Darcy

RECEIVED  
REGISTRATION COMMISSION  
JUL 20 1966  
WICHITA, KANSAS