


STATE OF KANSAS
STATE CORPORATION COMMISSION

WELL PLUGGING RECORD

Give All Information Completely
Make Required Affidavit
Mail or Deliver Report to:
Conservation Division
State Corporation Commission
211 No. Broadway
Wichita, Kansas

Barber County, Sec. 32 Twp. 31S Rge. 13W (E) (W)
Location as "NE/CNWxSWx" or footage from lines SW NE NE
Lease Owner Lario Oil & Gas Company
Lease Name Brooks 'A' Well No. 1
Office Address 301 S. Market, Wichita, Kansas 67202
Character of Well (completed as Oil, Gas or Dry Hole) Dry Hole
Date well completed August 10 19 66
Application for plugging filed August 10 19 66
Application for plugging approved August 10 19 66
Plugging commenced August 10 19 66
Plugging completed August 10 19 66
Reason for abandonment of well or producing formation Dry Hole

NORTH

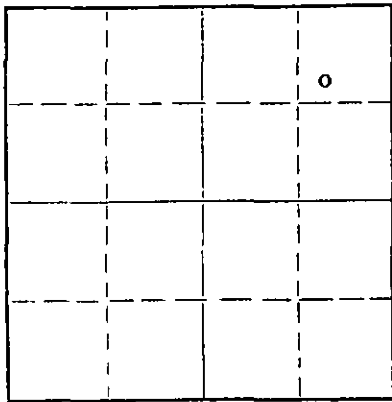

Locate well correctly on above
Section Plat

If a producing well is abandoned, date of last production 19
Was permission obtained from the Conservation Division or its agents before plugging was commenced? Yes

Name of Conservation Agent who supervised plugging of this well Archie V. Elving, Pratt, Kansas
Producing formation _____ Depth to top _____ Bottom _____ Total Depth of Well 3715 Feet
Show depth and thickness of all water, oil and gas formations.

OIL, GAS OR WATER RECORDS

CASING RECORD

FORMATION	CONTENT	FROM	TO	SIZE	PUT IN	PULLED OUT
		0	315'	8 5/8"	315'	None

Describe in detail the manner in which the well was plugged, indicating where the mud fluid was placed and the method or methods used in introducing it into the hole. If cement or other plugs were used, state the character of same and depth placed, from _____ feet to _____ feet for each plug set.

Set Plug: 275'/50 sacks cement & 1/2 sack hulls
40'/10 sacks cement & 1/2 sack hulls
2 sacks cement in rathole

RECEIVED
STATE CORPORATION COMMISSION
AUG 10 1966

CONSERVATION DIVISION
Wichita, Kansas

(If additional description is necessary, use BACK of this sheet)

Name of Plugging Contractor Hellar Drilling Company, Inc.
Address 1014 Union Center, Wichita, Kansas 67202

STATE OF Kansas COUNTY OF Sedgwick, ss.
D. L. Hellar, President of Hellar Drilling Co. Inc. (employee of owner) or (owner or operator) of the above-described well, being first duly sworn on oath, says: That I have knowledge of the facts, statements, and matters herein contained and the log of the above-described well as filed and that the same are true and correct. So help me God.

(Signature) D. L. Hellar D. L. Hellar, President
1014 Union Center, Wichita, Kansas
(Address)

SUBSCRIBED AND SWORN TO before me this 17th day of August, 19 66

My commission expires March 25, 1968. Catherine Darcey Notary Public.

Lario Oil & Gas Company
 Brooks "A" No. 1
 100' East of SW NE NE Sec. 32-31S-13W
 Barber County, Kansas

Drilling Commenced: 7-26-66
 Drilling Completed: 8-10-66
 Drilling Contractor: Hellar Drilling Company, Inc.
 Total Depth 3715'
 I.P. - D & A

Casing Record:
 8 5/8" 310.37 Set at 315'
 Cem. w/ 300 sacks

<u>Formation</u>	<u>Depth</u>
Surface	135
Shale and red bed	320
Red bed	1000
Shale & shells	1390
Salt section	1810
Salt section, lime & shale	1910
Ft. Riley	2101
Lime & shale	2244
Ft. Riley	2348
Shale & lime	2626
Shale & lime	2884
Lime & shale	3434
Shale & lime	3543
Shale w/ lime streaks	3595
Lime & shale	3609
Shale & lime	3648
Shale & sand	3715

<u>GEOLOGICAL TOPS:</u>	
<u>Elevation</u>	
1607'	Ground
1610'	D.F.
1613'	K.B.
3390'	Topeka (-1777)
3621'	Heebner (-2008)
3636'	Toronto (-2023)
3659'	Douglas Shale (-2046)
3695'	Douglas Sand (-2082)
3715'	Rotary total depth (-2102)

RECEIVED
 STATE CORPORATION COMMISSION

AUG 29 1966

CONSERVATION DIVISION
 Wichita, Kansas