

STATE OF KANSAS  
STATE CORPORATION COMMISSION

Give All Information Completely  
Make Required Affidavit  
Mail or Deliver Report to:  
Conservation Division  
State Corporation Commission  
211 No. Broadway  
Wichita, Kansas

WELL PLUGGING RECORD

Barber County, Sec. 20 Twp. 31S Rge. (E) 13 (W)

Location as "NE/CNW/SW" or footage from lines. Crt. NW SW

Lease Owner Graybol Oil Corporation

Lease Name Mills Well No. 1

Office Address 2200 N.B.T. Bldg., Tulsa, Oklahoma 74103

Character of Well (completed as Oil, Gas or Dry Hole) Dry Hole

Date well completed October 24 19 64

Application for plugging filed October 24 19 64

Application for plugging approved October 24 19 64


Plugging commenced October 25 19 64

Plugging completed October 25 19 64

Reason for abandonment of well or producing formation Dry hole

If a producing well is abandoned, date of last production \_\_\_\_\_ 19 \_\_\_\_\_

Was permission obtained from the Conservation Division or its agents before plugging was commenced? Yes

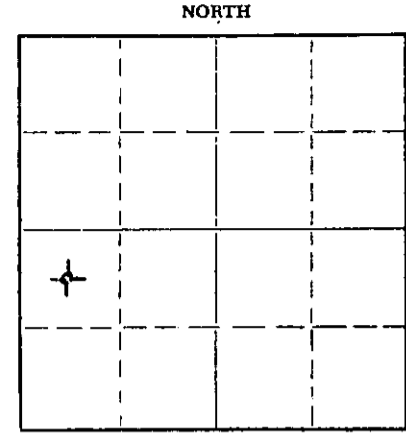

Locate well correctly on above Section Plat

Name of Conservation Agent who supervised plugging of this well Herman Justus

Producing formation None Depth to top \_\_\_\_\_ Bottom \_\_\_\_\_ Total Depth of Well 4566 Feet

Show depth and thickness of all water, oil and gas formations.

OIL, GAS OR WATER RECORDS

CASING RECORD

FORMATION	CONTENT	FROM	TO	SIZE	PUT IN	PULLED OUT
Douglas sand	Water	3701	3714	8 5/8"	286'	None
Lansing limestone	Water	3774	4016			
Mississippian	Impermeable	4234	4326			
Viola limestone	Impermeable	4424	4492			
Simpson sand	Water	4520	4530			

Describe in detail the manner in which the well was plugged, indicating where the mud fluid was placed and the method or methods used in introducing it into the hole. If cement or other plugs were used, state the character of same and depth placed, from \_\_\_\_\_ feet to \_\_\_\_\_ feet for each plug set.

Filled hole with heavy mud-laden fluid to 250'. Then placed in one-quarter sack of hulls, then a wooden plug. Next 25 sacks of Portland Cement. Filled hole with heavy mud-laden fluid to 40', put in one-quarter sack of hulls, then a wooden plug. Then ten sacks of Portland Cement which filled hole to top of surface. Put two sacks of Portland Cement in rat-hole.

RECEIVED  
STATE CORPORATION COMMISSION

OCT 27 1964

CONSERVATION DIVISION  
Wichita, Kansas

(If additional description is necessary, use BACK of this sheet)

Name of Plugging Contractor None used.

Address \_\_\_\_\_

STATE OF OKLAHOMA, COUNTY OF TULSA, ss.

Lyman C. Dennis (employee of owner) or (~~owner or operator~~) of the above-described well, being first duly sworn on oath, says: That I have knowledge of the facts, statements, and matters herein contained and the log of the above-described well as filed and that the same are true and correct. So help me God.

(Signature) Lyman C. Dennis

Tulsa, Oklahoma (Address)

SUBSCRIBED AND SWORN TO before me this 26th day of October, 19 64

My commission expires October 2, 1967

Notary Public.

GRAYBOL OIL CORPORATION

Barber County, Kansas

No. 1 Mills

Ctr. NW SW Sec. 20-31S-13W

Contractor: Company Tools

Elev. 1575 D.F., 1569 G.L.

Commenced: October 6, 1964

Completed: October 24, 1964

Production: Dry and Abandoned

CASING RECORD

Set 8 5/8" casing at 286' with 200 sacks pozmix cement.

DEPTH	FORMATION	WELEX ELECTROLOG TOPS:	
0-80	Sand and red bed	Stone Corral anhydrite	506 (+1069)
80-140	Red bed	Heebner shale	3562 (-1987)
140-695	Red bed, shale and shells	Lower Douglas sand	3701 (-2126)
695-1015	Red bed and shale	Brown Lime	3726 (-2151)
1015-1715	Shale and shells	Lansing Limestone	3742 (-2167)
1715-2625	Lime and shale	Base of Kansas City	4162 (-2587)
2625-3165	Shale and lime	Marmaton Limestone	4183 (-2608)
3165-3250	Lime and shale	Reworked Mississippian	4234 (-2659)
3250-3325	Lime	Mississippian	4297 (-2722)
3325-3485	Lime and shale	Kinderhook shale	4328 (-2753)
3485-3740	Shale and lime	Chattanooga shale	4383 (-2808)
3740-4155	Lime	Viola limestone	4396 (-2821)
4155-4181	Lime and shale	Simpson shale	4497 (-2922)
4181-4370	Lime	Simpson sand	4520 (-2945)
4370-4406	Shale and lime		
4406-4467	Lime	Drill Stem Test No. 1 4285-4310. Open	
4467-4481	Cherty lime and shale	one hour. Recovered 20' drilling mud.	
4481-4518	Lime and shale	I & FBHP - 45#/30", I & FFP-45#. BHT. 111°.	
4518-4555	Lime, shale and sand		
4555-4566	Shale		
4566	Driller's Total Depth		

I hereby certify that the above is a true and correct log of the above-captioned well as taken directly from the daily drilling reports.

GRAYBOL OIL CORPORATION

RECEIVED  
STATE CORPORATION COMMISSION

OCT 27 1964

BY: Lyman C. Dennis  
Lyman C. Dennis, Geologist

STATE OF OKLAHOMA CONSERVATION DIVISION  
Wichita, Kansas

COUNTY OF TULSA

Subscribed and sworn to this 26th day of October, 1964.

My Commission expires: October 2, 1967

Harvey Lee Elder  
NOTARY PUBLIC