

Give All Information Completely
Make Required Affidavit
Mail or Deliver Report to:
Conservation Division
State Corporation Commission
211 No. Broadway
Wichita, Kansas

WELL PLUGGING RECORD

Barber County, Sec. 20 Twp. 31S Rge. 13W (X) (W)

Location as "NE/CNW/SW" or footage from lines C SE NE

Lease Owner Jones-Gebert Oil Co.

Lease Name Hartley Well No. 1

Office Address 1007 Central Bldg., Wichita, Kansas

Character of Well (completed as Oil, Gas or Dry Hole) Dry Hole

Date well completed 10/28 1962

Application for plugging filed 10/29 1962

Application for plugging approved 10/29 1962


Plugging commenced 10/29 1962

Plugging completed 10/29 1962

Reason for abandonment of well or producing formation Dry Hole

If a producing well is abandoned, date of last production 19

Was permission obtained from the Conservation Division or its agents before plugging was commenced? Yes

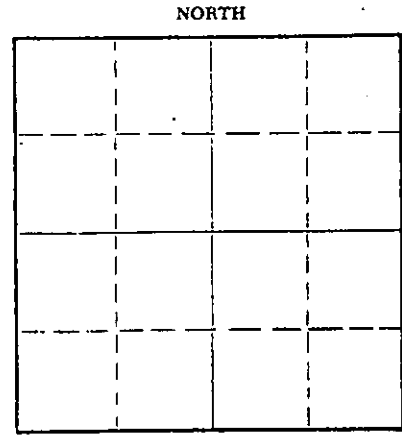

Locate well correctly on above Section Plat

Name of Conservation Agent who supervised plugging of this well Herman E. Justus

Producing formation _____ Depth to top _____ Bottom _____ Total Depth of Well 4544 Feet

Show depth and thickness of all water, oil and gas formations.

OIL, GAS OR WATER RECORDS

CASING RECORD

FORMATION	CONTENT	FROM	TO	SIZE	PUT IN	PULLED OUT
				8-5/8"	290'	

Describe in detail the manner in which the well was plugged, indicating where the mud fluid was placed and the method or methods used in introducing it into the hole. If cement or other plugs were used, state the character of same and depth placed, from _____ feet to _____ feet for each plug set.

Set Bottom Plug @ 160' with 1/4 sk, hulls and 20 sks. cement, mud to 40' set plug with 1/4 sk. hulls and 10 sks. cement, 2 sks. cement in rat hole.

RECEIVED
STATE CORPORATION COMMISSION

NOV 1 1962 11:11 AM

CONSERVATION DIVISION
Wichita, Kansas

(If additional description is necessary, use BACK of this sheet)

Name of Plugging Contractor Jones-Gebert Oil, Inc.

Address 1007 Central Building, Wichita, Kansas

STATE OF KANSAS, COUNTY OF SEDGWICK, ss. George R. Jones (owner or operator) of the above-described well, being first duly sworn on oath, says: That I have knowledge of the facts, statements, and matters herein contained and the log of the above-described well as filed and that the same are true and correct. So help me God.

(Signature) *George R. Jones*

1007 Central Building, Wichita, Kansas (Address)

SUBSCRIBED AND SWORN to before me this 30th day of October, 1962

Barbara J. Layton
Barbara J. Layton Notary Public.

My commission expires February 1, 1964



DRILLERS' LOG

Company:	Jones-Gebert Oil Co.
Contractor:	Jones-Gebert Oil, Inc.
Farm:	#1 Hartley
	C SE NE, Sec. 20-31S-13W
	Barber County, Kansas
Commenced:	10/9/62
Completed:	10/28/62
Casing:	290' of 8-5/8" w/250 sx.

0	-	290	Surface
290	-	360	Shale
360	-	1200	Shale & Shells
1200	-	1640	Shale
1640	-	1815	Shale & Lime Streaks
1815	-	1960	Lime
1960	-	2112	Lime
2112	-	2230	Lime
2230	-	2290	Lime & Shale
2290	-	2435	Lime w/shale streaks
2435	-	2550	Lime & Shale
2550	-	2705	Shale & Lime
2705	-	2887	Shale & Lime
2887	-	3015	Shale & Lime Streaks
3015	-	3110	Shale & Lime
3110	-	3180	Lime & Shale
3180	-	3190	Lime & Shale
3190	-	3300	Lime & Shale
3300	-	3322	Lime & Shale
3322	-	3414	Lime & Shale
3414	-	3517	Shale & Lime
3517	-	3563	Shale & Lime
3563	-	3598	Lime & Shale
3598	-	3691	Lime & Shale
3691	-	3742	Doug Sand & K.C. Lime
3742	-	3744	Lime & Shale & Sand
3744	-	3782	K.C. - Lime
3782	-	3832	K.C. - Lime
3832	-	3875	Lime
3875	-	3937	Lime & Shale
3937	-	3991	Lime
3991	-	4024	Lime & Shale
4024	-	4062	Lime w/chert
4062	-	4072	Lime
4072	-	4113	Lime
4113	-	4148	Lime
4148	-	4180	Lime
4180	-	4225	Lime & Chert
4225	-	4269	Lime & Shale w/chert
4269	-	4270	Chert
4270	-	4280	Miss.
4280	-	4298	Cherty Lime
4298	-	4350	Lime & Chert Sections

RECEIVED
 STATE CORPORATION COMMISSION
 NOV 1 1962
 CONSERVATION DIVISION
 Wichita, Kansas

DRILLERS' LOG

Page -2-

4350	-	4409	Lime & Chert & Shale
4409	-	4437	Lime
4437	-	4467	Lime
4467	-	4481	Lime & Chert
4481	-	4512	Lime & Shale
4512	-	4517	Simpson ?
4517	-	4543	Lime, Sand-Dolomite
4543	-	4544	Rotary Total Depth

I, George R. Jones, do hereby certify that the above and foregoing is a true and correct copy of the log of the #1 Hartley, C SE NE, Sec. 20-31S-13W, Barber County, Kansas, as reflected by the files of Jones-Gebert Oil, Inc.

George R. Jones
George R. Jones

State of Kansas)
) ss.
County of Sedgwick)

Subscribed and sworn to before me, a Notary Public, in and for Sedgwick County, Kansas this 30th day of October, 1962.

Barbara J. Layton
Barbara J. Layton, Notary Public

My Commission expires:
February 1, 1964

RECEIVED
STATE CORPORATION COMMISSION

NOV 1 1962

CONSERVATION DIVISION
Wichita, Kansas