

WELL PLUGGING RECORD

Give All Information Completely
Make Required Affidavit
Mail or Deliver Report to:
Conservation Division
State Corporation Commission
211 No. Broadway
Wichita, Kansas

Barber County, Sec. 24 Twp. 31S Rge. 13(W)

Location as "NE/CNW&SW&" or footage from lines NE - NE - NW

Lease Owner Champlin Oil & Refining Co.

Lease Name Susie Smith Well No. 1

Office Address P. O. Box 308, Ellinwood, Kansas

Character of Well (completed as Oil, Gas or Dry Hole) Gas

Date well completed March 30, 1953

Application for plugging filed January 17, 1964


Application for plugging approved January 21, 1964

Plugging commenced January 28, 1964

Plugging completed February 1, 1964

Reason for abandonment of well or producing formation Production Nil

NORTH

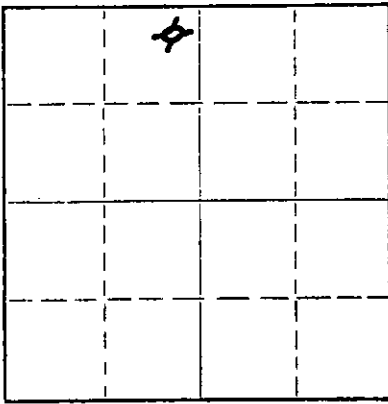

Locate well correctly on above
Section Plat

If a producing well is abandoned, date of last production 19

Was permission obtained from the Conservation Division or its agents before plugging was commenced? Yes

Name of Conservation Agent who supervised plugging of this well Archie Elving, Pratt, Kansas

Producing formation Depth to top Bottom Total Depth of Well 3650' Feet

Show depth and thickness of all water, oil and gas formations.

OIL, GAS OR WATER RECORDS

CASING RECORD

FORMATION	CONTENT	FROM	TO	SIZE	PUT IN	PULLED OUT
				10 3/4" OD	190'	None
				7" OD	3649'	2895'

Describe in detail the manner in which the well was plugged, indicating where the mud fluid was placed and the method or methods used in introducing it into the hole. If cement or other plugs were used, state the character of same and depth placed, from feet to feet for each plug set.

Filled hole with sand from 3650' TD to 3560' then mixed and dumped

5 sacks of cement filling hole to 3535'. Mudded hole to 250'. Set rock

bridge from 250' to 240' and mixed and dumped 40 sacks of cement filling

hole to 160', then mudded hole to 40' and set 10' rock bridge to 30' and

mixed and dumped 15 sacks of cement filling hole from 30' to base of

cellar.

(If additional description is necessary, use BACK of this sheet)

Name of Plugging Contractor Ace Pipe Pulling Co. Permit #2

Address P. O. Box 304, Great Bend, Kansas

STATE OF KANSAS, COUNTY OF BARTON, ss.

J. W. Meyers (employee of owner) or (owner or operator) of the above-described

well, being first duly sworn on oath, says: That I have knowledge of the facts, statements, and matters herein contained and the log of the above-described well as filed and that the same are true and correct. So help me God.

(Signature) [Handwritten Signature]

P. O. Box 308, Ellinwood, Kansas

(Address)

SUBSCRIBED AND SWORN to before me this 10th day of February, 1964

[Handwritten Signature]

Notary Public.

My commission expires 5-22-66.

RECEIVED
STATE CORPORATION COMMISSION

2-11-64

FEB 11 1964 FEB

CONSERVATION DIVISION
STATE CORPORATION COMMISSION

Champlin Oil & Refining Co.

Susie H. Smith #1
NE-NE-NW of Sec. 24-31S-13W
Barber County, Kansas

Drillers' Formation Log

0' - 442'	Red Bed
442' - 536'	Red Bed & Shells
536' - 1367'	Shale & Shells
1367' - 1400'	Anhydrite
1400' - 1420'	Shale
1420' - 1630'	Shale & Shells
1630' - 1770'	Shale & Lime Streaks
1770' - 2365'	Lime & Shale
2365' - 2580'	Shale & Lime
2580' - 2830'	Shale & Lime Streaks
2830' - 3540'	Shale & Lime
3540' - 3590'	Lime & Shale
3590' - 3616'	Sand
3616' - 3650'	Shale
3650'	Total Depth

RECEIVED
STATE CORPORATION COMMISSION

JAN 21 1964

CONSERVATION DIVISION
Wichita, Kansas