


STATE OF KANSAS
STATE CORPORATION COMMISSION

WELL PLUGGING RECORD

Give All Information Completely
Make Required Affidavit
Mail or Deliver Report to:
Conservation Division
State Corporation Commission
800 Biting Building
Wichita, Kansas

Barber County. Sec. 24 Twp. 31s Rge. (E) 13(W)
Location as "NE/CNW/SW" or footage from lines NE $\frac{1}{2}$ -NW $\frac{1}{2}$ -SW $\frac{1}{2}$
Lease Owner Champlin Refining Company
Lease Name Roessler Well No. 1 A
Office Address P.O. Drawer #552, Enid, Oklahoma
Character of Well (completed as Oil, Gas or Dry Hole) Dry hole
Date well completed March 26, 19 53
Application for plugging filed March 26, 19 53
Application for plugging approved March 26, (Verbal) 19 53
Plugging commenced March 26, 19 53
Plugging completed March 26, 19 53
Reason for abandonment of well or producing formation _____

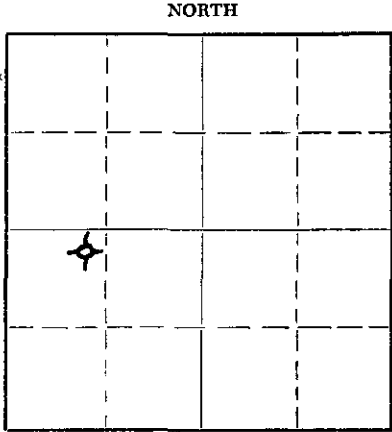

Locate well correctly on above
Section Plat

If a producing well is abandoned, date of last production _____ 19 ____
Was permission obtained from the Conservation Division or its agents before plugging was commenced? Yes

Name of Conservation Agent who supervised plugging of this well M. A. Rives
Producing formation _____ Depth to top _____ Bottom _____ Total Depth of Well 3950 Feet
Show depth and thickness of all water, oil and gas formations.

OIL, GAS OR WATER RECORDS

CASING RECORD

FORMATION	CONTENT	FROM	TO	SIZE	PUT IN	PULLED OUT
				8 5/8 OD 10 3/4" OD	186'	None
					Set at 196'	

Describe in detail the manner in which the well was plugged, indicating where the mud fluid was placed and the method or methods used in introducing it into the hole. If cement or other plugs were used, state the character of same and depth placed, from _____ feet to _____ feet for each plug set.

Filled hole with heavy rotary mud from 3950' T.D. to 190' set wooden plug at 190' and pumped in 20 sacks of cement thru the drill pipe. Then filled hole with heavy mud from top of cement to 20' and set wooden plug at 20' and pumped in 10 sacks of cement filling hole to bottom of cellar.

RECEIVED
STATE CORPORATION COMMISSION
4-2-53 APR 2 - 1953
CONSERVATION DIVISION
WICHITA, KANSAS

Name of Plugging Contractor R. C. Patton (Rotary)
Address Wichita, Kansas

STATE OF Kansas, COUNTY OF Barton, ss.
S. P. Hall (employee of owner) or (~~XXXXXXXXXX~~) of the above-described well, being first duly sworn on oath, says: That I have knowledge of the facts, statements, and matters herein contained and the log of the above-described well as filed and that the same are true and correct. So help me God.

(Signature) S. P. Hall
P.O. Box 167, Ellinwood, Kansas
(Address)

SUBSCRIBED AND SWORN to before me this 31st day of March 19 53

My commission expires September 10, 1955 N. Kenneth Stearns Notary Public.

PLUGGING
FILE SEC 24 T 31 R 13W
BOOK PAGE 22 LINE 19

Champlin Refining Company
 Roessler A #1
 NE $\frac{1}{4}$ -NW $\frac{1}{4}$ -SW $\frac{1}{4}$
 Section 24 T31s 13w
 Barber County, Kansas

0' - 198' Redbed & Shale
 198' - 1360' Shale & Shells
 1360' - 1675' Lime & Shale
 1675' - 1750' Lime
 1750' - 1835' Lime & Shale Bks.
 1835' - 1900' Lime & Shale
 1900' - 2015' Lime & Shale
 2015' - 2090' Lime
 2090' - 2165' Lime & Shale
 2165' - 2235' Lime
 2235' - 2280' Lime
 2280' - 2340' Lime & Shale
 2340' - 2480' Shale & Lime
 2480' - 2665' Lime & Shale
 2665' - 2815' Shale & Shells
 2820' - 3090' Lime & Shale
 3090' - 3335' Lime & Shale
 3335' - 3465' Lime & Shale
 3465' - 3515' Lime & Shale Brks.
 3515' - 3560' Lime & Shale
 3560' - 3564' Lime
 3564' - 3578' Sand
 3578' - 3585' Sand
 3585' - 3615' Sand
 3615' - 3645' Sandy Shale
 3645' - 3695' Lime & Shale
 3695' - 3755' Lime
 3745' - 3890' Lime
 3890' - 3950' Lime
 3950' T.D.

Plugged and abandoned

Filled hole with heavy mud-Set wooden plug at 190'-Pumped 20 sx cement on plug through drill pipe. Filled hole with mud to 20'-Set plug-Cemented to cellar with 10 sx. Finished plugging at 5:45 A.M. 3-27-53.

APR 2 1953
 CONSERVATION DIVISION
 Barber County, Kansas

PLUGGING
 FILE SEC 24 T 31 R 13w
 BOOK PAGE 88 LINE 19