


STATE OF KANSAS
STATE CORPORATION COMMISSION

Give All Information Completely
Make Required Affidavit
Mail or Deliver Report to:
Conservation Division
State Corporation Commission
212 North Market, Insurance Bldg.
Wichita, Kansas

WELL PLUGGING RECORD

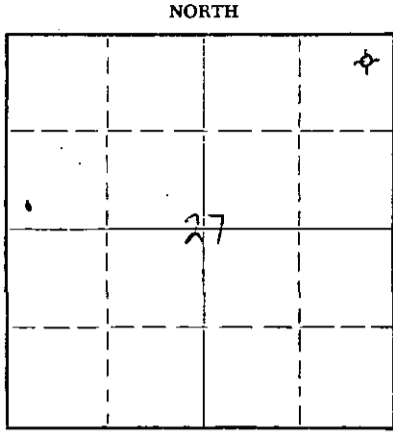

Locate well correctly on above
Section Plat

Barber County, Sec. 27 Twp. 31S Rge. 13 (E) W (W)
Location as "NE/CNW&SW&" or footage from lines C NE NE NE
Lease Owner Broadhurst & Cassidy
Lease Name McGuire Well No. 1
Office Address First National Building Tulsa 3, Oklahoma
Character of Well (completed as Oil, Gas or Dry Hole) Dry Hole
Date well completed July 5 19 61
Application for plugging filed July 5 19 61
Application for plugging approved July 5 19 61
Plugging commenced July 5 19 61
Plugging completed July 5 19 61
Reason for abandonment of well or producing formation Dry Hole

If a producing well is abandoned, date of last production 19____
Was permission obtained from the Conservation Division or its agents before plugging was com-
menced? Yes

Name of Conservation Agent who supervised plugging of this well Fred Hampel
Producing formation _____ Depth to top _____ Bottom _____ Total Depth of Well 4500 Feet
Show depth and thickness of all water, oil and gas formations.

OIL, GAS OR WATER RECORDS

CASING RECORD

FORMATION	CONTENT	FROM	TO	SIZE	PUT IN	PULLED OUT

Describe in detail the manner in which the well was plugged, indicating where the mud fluid was placed and the method or methods used in introducing it into the hole. If cement or other plugs were used, state the character of same and depth placed, from _____ feet to _____ feet for each plug set.

4500' to 240' - Heavy rotary mud
240' to 194' - 1/4 sack hulls, plug and 15 sacks cement
194' to 40' - Heavy rotary mud
40' to 6' - 1/4 sack hulls, plug and 10 sacks cement
6' to Surface-Cellar
25 sacks, in rathole. ~~25 sacks cement~~
cement

RECEIVED
STATE CORPORATION COMMISSION
JUL 11 1961
CONSERVATION DIVISION
Wichita, Kansas

(If additional description is necessary, use BACK of this sheet)
Name of Plugging Contractor PEEL BROTHERS, INC.
Address P. O. Box 359 Hoisington, Kansas

STATE OF KANSAS, COUNTY OF BARTON, ss.
Peel Brothers, Inc. (employee of owner) or (owner) of the above-described well, being first duly sworn on oath, says: That I have knowledge of the facts, statements, and matters herein contained and the log of the above-described well as filed and that the same are true and correct. So help me God. PEEL BROTHERS, INC.

(Signature) Handell P. Peel
P. O. Box 359 Hoisington, Kansas
(Address)

SUBSCRIBED AND SWORN TO before me this 6 day of July 1961

Ruth Brant
Notary Public.

My commission expires April 27, 1964

INVOICED
DATE 7/18/61
INV. NO. 3349-W


WELL LOG BUREAU—KANSAS GEOLOGICAL SOCIETY
 508 East Murdock, Wichita, Kansas

Company- BROADHURST & CASSIDY
 Farm- McGuire No. 1

SEC. 27 T. 31 R. 13W
 NE NE NE

Well Depth. 4500'
 Date. 6-19-61 Comp. 7-5-61
 Well or Treated.
 Dr. Contractor. Peel Brothers, Inc.
 Cased. 9-30-61

County Barber
 KANSAS

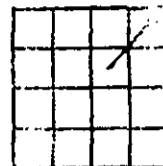

CASING:
 8" 250'

Elevation. 1569' RB

Production. Dry

Figures Indicate Bottom of Formations.

cement	200
shale & shells	1665
shale & lime	1795
lime	1839
lime & shale	3000
shale	3071
lime	3165
lime & shale	3445
lime	3505
lime & shale	3673
lime	4114
lime & chert	4139
lime	4250
lime & chert	4379
lime, chert & shale	4440
lime	4465
lime & chert	4495
lime	4500
Total Depth	

TOPS: SCOUT	
Heebner	3508
Douglas "A"	3597
Douglas "B"	3671
Lansing	3713
Mississippi	4202