


STATE OF KANSAS
STATE CORPORATION COMMISSION

WELL PLUGGING RECORD

Give All Information Completely
Make Required Affidavit
Mail or Deliver Report to
Conservation Division
State Corporation Comm.
245 North Water
Wichita, KS 67202

Barber County, Sec. 30 Twp. 31S Rge. 13 ~~W~~/W
Location as "NE/CNW $\frac{1}{4}$ SW $\frac{1}{4}$ " or footage from lines
C NE NW

Lease Owner Hummon Oil Company & Leonard M. Ropfogel
Lease Name Mills Well No. 1
Office Address 1725 Vickers KSB&T Bldg., Wichita, Ks. 67202
Character of Well (Completed as Oil, Gas or Dry Hole)
Dry Hole

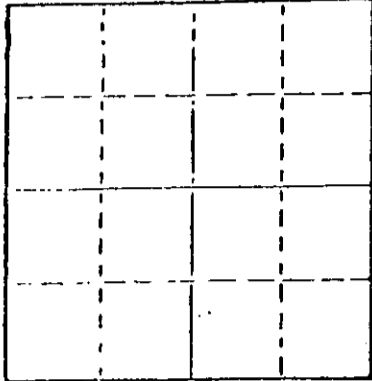

Locate well correctly on above
Section Plat

Date Well completed May 25 1978
Application for plugging filed June 2 1978
Application for plugging approved May 31, 1978
Plugging commenced May 25 1978
Plugging completed May 25 1978
Reason for abandonment of well or producing formation
Non-commercial

If a producing well is abandoned, date of last production
NA 19

Was permission obtained from the Conservation Division or
its agents before plugging was commenced? Yes

Name of Conservation Agent who supervised plugging of this well Bill Owens
Producing formation _____ Depth to top _____ Bottom _____ Total Depth of Well 3895'
Show depth and thickness of all water, oil and gas formations.

OIL, GAS OR WATER RECORDS

CASING RECORD

FORMATION	CONTENT	FROM	TO	SIZE	PUT IN	PULLED OUT
				8-5/8	234	

Describe in detail the manner in which the well was plugged, indicating where the mud fluid
was placed and the method or methods used in introducing it into the hold. If cement or other
plugs were used, state the character of same and depth placed, from _____ feet to
_____ feet for each plug set.

1st plug set @ 240' w/40sx.
2nd plug & bridge set 40' w/12sx.
5sx. in rathole

STATE CORPORATION COMMISSION

JUN 05 1978 6-5-78

CONSERVATION DIVISION
Wichita, Kansas

(If additional description is necessary, use BACK of this sheet)

Name of Plugging Contractor Gabbert-Jones, Inc.

STATE OF KANSAS COUNTY OF SEDGWICK, ss.
Byron E. Hummon, Jr. (employee of owner) or (owner or operator)

of the above-described well, being first duly sworn on oath, says: That I have knowledge of
the facts, statements, and matters herein contained and the log of the above-described well
as filed and that the same are true and correct. So help me God.

(Signature) [Signature]
1725 Vickers KSB&T Bldg., Wichita, Ks. 67202
(Address)

SUBSCRIBED AND SWORN TO before me this 2nd day of June, 1978

[Signature]
Sandra L. Mendoza Notary Public.

My commission expires February 13, 1982

SANDRA L. MENDOZA
STATE NOTARY PUBLIC
SEDGWICK COUNTY, KANSAS
MY APPT. EXP. 2/13/82

GABBERT-JONES, INC.
 WICHITA, KANSAS
 DRILLERS' WELL LOG

Hills #1
 C-NE-NW Sec 30-318-13W
 Barber County Kansas

Commenced: 5-15-78

Completed: 5-25-78

OPERATOR: HUMMON OIL CO.

Depth From	to	Formation	Remarks
0	690	Redbed-Rock	Run 6 jts of 280 8 5/8" cog
690	1190	Redbed	out @ 234' Cemented w/175 aka
1190	1560	Clay-Shale	Common 3% CC
1560	1700	Shale	PP @ 3:30 p.m. 5-16-78
1700	2713	Shale-Lime	
2713	3525	Lime-Shale	
3525	3685	Lime	
3685	3895	Lime-Shale	
	3895 - TD		DRY & ABANDONED

STATE OF KANSAS)
) SS
 COUNTY OF SEDGWICK)

I, the undersigned, being duly sworn on oath, state that the above
 Drillers' Well Log is true and correct to the best of my knowledge and belief and
 according to the records of this office.

GABBERT-JONES, INC.

James S. Sutton II
 JAMES S. SUTTON II

Subscribed and sworn to before me this 31st day of May, 1978.

Elizabeth J. Edwards
 ELIZABETH J. EDWARDS-NOTARY PUBLIC

My Commission expires February 6, 1979.

RECEIVED
 STATE COMMISSIONER OF REVENUE
 JUN 05 1978
 COMMISSIONER OF REVENUE
 Kansas

