

STATE OF KANSAS  
STATE CORPORATION COMMISSION

Form CP-4


Give All Information Completely  
Make Required Affidavit  
Mail or Deliver Report to:  
Conservation Division  
State Corporation Commission  
212 No. Market  
Wichita, Kansas

WELL PLUGGING RECORD

BARBER County, Sec. 28 Twp. 32S Rge. 12 (E) (W)

Location as "NE/CNW&SWX" or footage from lines. APP. C NE NW  
Lease Owner PETROLEUM, INC.,  
Lease Name KIRKBRIDE 'B' Well No. 1  
Office Address R.R. #2, GREAT BEND, KANSAS  
Character of Well (completed as Oil, Gas or Dry Hole) DRY HOLE  
Date well completed MARCH 12 19 67  
Application for plugging filed MARCH 12 19 67  
Application for plugging approved MARCH 12 19 67  
Plugging commenced MARCH 12 19 67  
Plugging completed MARCH 12 19 67  
Reason for abandonment of well or producing formation NO PRODUCIBLE ZONE

NORTH

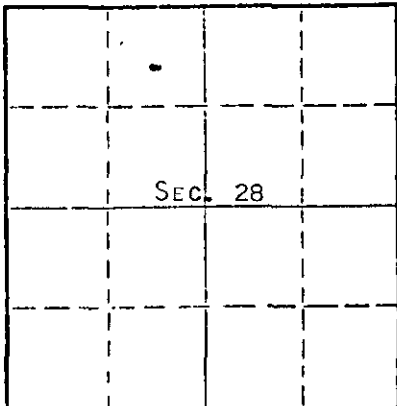

Locate well correctly on above  
Section Plat

If a producing well is abandoned, date of last production 19  
Was permission obtained from the Conservation Division or its agents before plugging was commenced? YES

Name of Conservation Agent who supervised plugging of this well ARCHIE FLIVING  
Producing formation Depth to top Bottom Total Depth of Well 4470 Feet  
Show depth and thickness of all water, oil and gas formations.

OIL, GAS OR WATER RECORDS

CASING RECORD

FORMATION	CONTENT	FROM	TO	SIZE	PUT IN	PULLED OUT
				8-5/8"	317	NONE

Describe in detail the manner in which the well was plugged, indicating where the mud fluid was placed and the method or methods used in introducing it into the hole. If cement or other plugs were used, state the character of same and depth placed, from feet to feet for each plug set.

MUD TO 300', FOLLOWED BY WOODEN PLUG, 1/2 SACK HULLS, 25 SACKS CEMENT ON TOP OF PLUG. MUD TO 40', FOLLOWED BY WOODEN PLUG, 1/2 SACK HULLS, 10 SACKS CEMENT ON TOP OF PLUG TO BASE OF WELL CELLAR.

RECEIVED  
STATE CORPORATION COMMISSION

3-29-67  
MAR 20 1967

CONSERVATION DIVISION  
Wichita, Kansas

(If additional description is necessary, use BACK of this sheet)

Name of Plugging Contractor GARVEY DRILLING COMPANY  
Address R.R. #2, GREAT BEND, KANSAS

STATE OF KANSAS, COUNTY OF BARTON, ss.  
MONTE CHADD (employee of owner) or (owner or operator) of the above-described well, being first duly sworn on oath, says: That I have knowledge of the facts, statements, and matters herein contained and the log of the above-described well as filed and that the same are true and correct. So help me God. MONTE CHADD, DIST. PROB. SUPT.

(Signature) [Signature]  
R.R. #2, GREAT BEND, KANSAS  
(Address)

SUBSCRIBED AND SWORN TO before me this 28 day of MARCH, 19 67

My commission expires MAY 28, 1969 [Signature] Notary Public.

# WELL LOG

COMPANY Petroleum, Inc

SEC. 28 T. 32S R. 12W

FARM Kirkbride

NO. B-1

LOC. C NE NW

TOTAL DEPTH 4470'


COUNTY Barber

COMM. 3-1-67

COMP. 3-12-67

CONTRACTOR Garvey Drilling Company

CASING 8 5/8" @ 317' w/235 sx

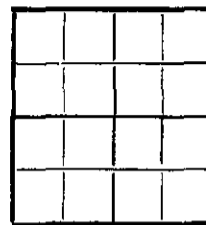

ELEVATION 1535' KB

PRODUCTION D & A

FIGURES INDICATE BOTTOM OF FORMATIONS

.35' Surface Shells and Red Bed  
800' Red Bed  
1620' Shale and Shells with Lime Streaks  
1735' Shale and Lime Streaks  
1935' Shale and Lime  
2250' Lime and Shale  
2417' Lime with Shale streaks  
2660' Lime and Shale  
3145' Shale and Lime  
3440' Lime and Shale  
3579' Shale and Lime  
3818' Lime with Shale and Sand  
3930' Lime and Shale  
4362' Lime  
4395' Mississippi Chert  
4413' Mississippi  
4470' Lime and Shale  
4470' RTD

RECEIVED  
OIL CORPORATION COMMISSION  
MAR 29 1967  
CONSERVATION DIVISION  
Wichita, Kansas

State of Kansas  
County of Barton } SS

I, Sam N. Stephens of Garvey Drilling Company

upon oath state the above and foregoing is a true and correct copy of the log of the Kirkbride B-1 well.

Sam N. Stephens

Subscribed and sworn to before me this 22nd day of March 19 67

My Commission Expires: November 5th, 1969

Richard D. Doy  
NOTARY PUBLIC