

STATE OF KANSAS  
STATE CORPORATION COMMISSION


WELL PLUGGING RECORD

Give All Information Completely  
Make Required Affidavit  
Mail or Deliver Report to:  
Conservation Division  
State Corporation Commission  
800 Bitting Building  
Wichita, Kansas

Barber County, Sec. 11 Twp. 32 Rge. 12 (E) W (W)

Location as "NE/CNW%SW%" or footage from lines NE NE SW  
Lease Owner Harms - Burt Drilling Company  
Lease Name Adams Well No. 1  
Office Address Box 184, Great Bend, Kansas  
Character of Well (completed as Oil, Gas or Dry Hole) Dry Hole  
Date well completed April 11, 1955  
Application for plugging filed April 11, 1955  
Application for plugging approved April 11, (orally) 1955  
Plugging commenced April 11, 1955  
Plugging completed April 11, 1955  
Reason for abandonment of well or producing formation Dry Hole

NORTH

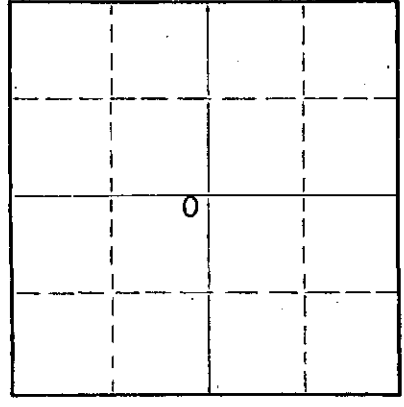

Locate well correctly on above Section Plat

If a producing well is abandoned, date of last production 19  
Was permission obtained from the Conservation Division or its agents before plugging was commenced? Yes

Name of Conservation Agent who supervised plugging of this well M. A. Rives, Box 8, Pratt, Kansas  
Producing formation \_\_\_\_\_ Depth to top \_\_\_\_\_ Bottom \_\_\_\_\_ Total Depth of Well 4329 Feet  
Show depth and thickness of all water, oil and gas formations.

OIL, GAS OR WATER RECORDS

CASING RECORD

FORMATION	CONTENT	FROM	TO	SIZE	PUT IN	PULLED OUT
Surface		0	205	8 5/8"	205'	none

Describe in detail the manner in which the well was plugged, indicating where the mud fluid was placed and the method or methods used in introducing it into the hole. If cement or other plugs were used, state the character of same and depth placed, from \_\_\_\_\_ feet to \_\_\_\_\_ feet for each plug set.

Filled hole with mud from 4329 TD to 200'  
Set plug at 200' with 20 sacks of cement on top.  
Heavy mud to 30' with plug set at 35'  
10 sacks of cement on top of plug.

RECEIVED  
STATE CORPORATION COMMISSION  
Wichita, Kansas  
5-14-55 MAY 14 1955  
CONSERVATION DIVISION  
Wichita, Kansas

(If additional description is necessary, use BACK of this sheet)  
Name of Plugging Contractor Harms - Burt Drilling Company  
Address Box 184, Great Bend, Kansas

STATE OF Kansas, COUNTY OF Barton, ss.  
Allan Harms (employee of owner) or (owner or operator) of the above-described well, being first duly sworn on oath, says: That I have knowledge of the facts, statements, and matters herein contained and the log of the above-described well as filed and that the same are true and correct. So help me God.

(Signature) Allan Harms  
Box 184, Great Bend, Kansas.  
(Address)

SUBSCRIBED AND SWORN to before me this 13 day of May, 1955  
Mary E Van Pelt  
Notary Public.

My commission expires Jan. 20, 1958

PLUGGING  
FILED SEC. 11, T. 32, R. 12, S. 29  
MAY 11 1955

Driller's Log

Company: Harms-Burt Drilling Co.

Farm: Adams #1 NE NE SW

Sec. 11-32S-12W, Barber County, Kans.

Commenced: March 24, 1955

Completed: April 11, 1955

Elevation: 1459 RB

0-	45	Sand	3420-	3450	Sand, shale & shells
45-	205	Red bed & shells	3450-	3525	Lime & shale
205-	935	Shale & shells	3525-	3595	Lime & shale streaks
935-	943	Anhydrite	3595-	3624	Shale
943-	1035	Shale & Shells	3624-	3654	Sand
1035-	1445	Shale & shells & salt	3654-	3684	Shale & sand
1445-	2340	Lime & shale	3684-	3700	Lime
2340-	2605	Shale & Lime	3700-	3753	Lime & shale
2605-	2785	Shale with lime streaks	3753-	4243	Lime
2785-	2905	Lime	4243-	4249	Mississippi lime
2905-	3085	Lime & shale	4249-	4255	Chat
3085-	3190	Lime	4255-	4276	Lime
3190-	3290	Lime with shale streaks	4276-	4320	Chert
3290-	3369	Lime & shale	4320-	4329	Lime & chert
3369-	3420	Sand & shale	4329-		T.D.

Set 205' of 8 5/8" surface pipe cemented with 200 sacks of common cement and 5 sacks of calcium chloride.

Tops:	Anhydrite	935
	Elgin Sand	3360
	Douglas Sand	3623
	Lansing KC	3669
	Mississippian	4235

- Drill Stem Tests - No.1 3622-3634 Open 1 hr. recovered 185' muddy salt sater IFP 0 FFP 220# BHP 1260#
- No.2 4234-4243 Open 2 hrs. recovered 20' drilling mud. IFP 15# FFP 28# BHP 350#
- No.3 4234-4249 Open 2 hrs. gas in 1 1/2 hrs. recovered 120' oil cut mud. IFP 15# FFP 48# BHP 638#
- No.4 4249-4260 Open 2 hrs. recovered 12' slightly oilcut mud 50' watery mud IFP 15# FFP 28# BHP 160#

Ran electric log.  
Dry, Plugged & abandoned.

RECEIVED  
STATE CORPORATION OF KANSAS  
MAY 14 1955  
GENERAL INVESTIGATION DIVISION  
Topeka, Kansas

Affidavit: State of Kansas) ) SS  
County of Barton)

I, Allan Harms of Harms-Burt Drilling Company, being first duly sworn on oath state: That I have knowledge of the facts, statements, and matters herein contained and that the same are true and correct.

Signed Allan Harms

Subscribed and sworn to before me this 13 day of May, 1955:

Comm. Exp. 1-20-58

PLUGGING  
MAY 11 1955  
MAY 11 1955

Mary E Van Belt  
Notary Public

WELL LOG BUREAU--KANSAS GEOLOGICAL SOCIETY  
508 East Murdock, Wichita, Kansas


COPY

Company- HERMS-BURT DRILLING CO.  
Farm- Adams No. 1

SEC. 11 T. 32 R. 12W  
NE NE SW

Total Depth. 4329'  
Comm. 3-24-55 Comp. 4-11-55  
Shot or Treated.  
Contractor.  
Issued. 8-11-56

County Barber KANSAS

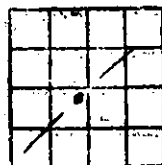

Elevation. 1459' RB

Production. Dry

CASING:

8 5/8" 205' cem. w/200 sx. & 5 sx of Cal. Cl.

Figures indicate Bottom of Formations

sand	45
red bed & shells	205
shale & shells	935
Anhydrite	943
shale & shells	1035
shale & shells & salt	1145
shale & lime	2605
shale w/lime streaks	2785
lime	2905
lime & shale	3085
lime	3190
lime w/shale streaks	3290
lime & shale	3369
sand & shale	3420
sand, shale & shells	3450
lime & shale	3525
lime & shale streaks	3595
shale	3624
sand & shale	3684
lime	3700
lime & shale	3753
lime	4243
Mississippi lime	4249
Chat	4255
lime	4276
Chert	4320
lime & Chert	4329
Total Depth	

TOPS:

Anhydrite	935
Elgin Sand	3360
Douglas Sand	3623
Lansing/Kansas City	3669
Mississippian	4235

DRILL STEM TESTS

- No. 1 3622-3634 open 1 hr. recovered 185' muddy salt wtr. IFP 0 FFP 220#  
BHP 1260#
- No. 2 4234-4243 open 2 hrs. recovered 20' drilling mud. IFP 15# FFP 28#  
BHP 350#
- No. 3 4234-4249 open 2 hrs. gas in 1 1/2 hrs. recovered 120' oil cut mud.  
IFP 15# FFP 48# BHP 638#
- No. 4 4249-4260 open 2 hrs. recovered 12' slightly oil cut mud 50' watery  
mud IFP 15# FFP 28# BHP 160#

RAN ELECTRIC LOG.