


STATE OF KANSAS
STATE CORPORATION COMMISSION

Give All Information Completely
Make Required Affidavit
Mail or Deliver Report to:
Conservation Division
State Corporation Commission
212 North Market, Insurance Bldg.
Wichita, Kansas

WELL PLUGGING RECORD

NORTH

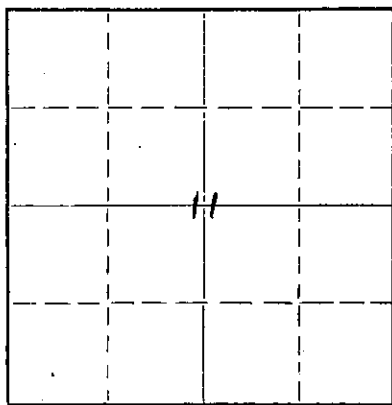

Locate well correctly on above
Section Plat

Barber County. Sec 11 Twp 32 Rge. 12 (E) W (W)

Location as "NE/CNW/SW" or footage from lines SE-SE-SW

Lease Owner Five Nation Drilling Co., Inc.

Lease Name Adams Well No. 1

Office Address 519 Beacon Building Wichita, Kansas

Character of Well (completed as Oil, Gas or Dry Hole) Dry Hole

Date well completed May 23 1960

Application for plugging filed May 23 1960

Application for plugging approved May 23 1960

Plugging commenced May 23 1960

Plugging completed May 23 1960

Reason for abandonment of well or producing formation Dry

If a producing well is abandoned, date of last production _____ 19____

Was permission obtained from the Conservation Division or its agents before plugging was commenced? Yes

Name of Conservation Agent who supervised plugging of this well F. Hampel

Producing formation _____ Depth to top _____ Bottom _____ Total Depth of Well 4338 Feet

Show depth and thickness of all water, oil and gas formations.

OIL, GAS OR WATER RECORDS

CASING RECORD

FORMATION	CONTENT	FROM	TO	SIZE	PUT IN	PULLED OUT
				8 5/8	220'	cemented top to bottom

Describe in detail the manner in which the well was plugged, indicating where the mud fluid was placed and the method or methods used in introducing it into the hole. If cement or other plugs were used, state the character of same and depth placed, from _____ feet to _____ feet for each plug set.

Heavy mud from 4338' to 210'-wooden plug-1/2 sack of hulls and 18 sacks cement through drill pipe-filled with mud to 35'-wooden plug at 35'-1/2 sack of hulls and 10 sacks cement-cut surface pipe below plow depth-put 2 sacks of cement in rat hole- job completed at 4 P.M.

RECEIVED
STATE CORPORATION COMMISSION

JUL 28 1960 7-28-60

CONSERVATION DIVISION
Wichita, Kansas

Name of Plugging Contractor Glen Drilling, Inc.
Address Box 631 El Dorado, Kansas
(If additional description is necessary, use BACK of this sheet)

STATE OF Kansas COUNTY OF Butler, ss.
employee of owner (employee of owner) or (owner or operator) of the above-described

well, being first duly sworn on oath, says: That I have knowledge of the facts, statements, and matters herein contained and the log of the above-described well as filed and that the same are true and correct. So help me God

(Signature) Allen Gains

Box 631 El Dorado, Kansas

(Address)

SUBSCRIBED AND SWORN TO before me this 26th day of may, 1960

April 28, 1962

My commission expires

Christian M. Jewell
Notary Public.

