


WELL PLUGGING RECORD

Give All Information Completely
Make Required Affidavit
Mail or Deliver Report to:
Conservation Division
State Corporation Commission
800 Bitting Building
Wichita, Kansas

NORTH

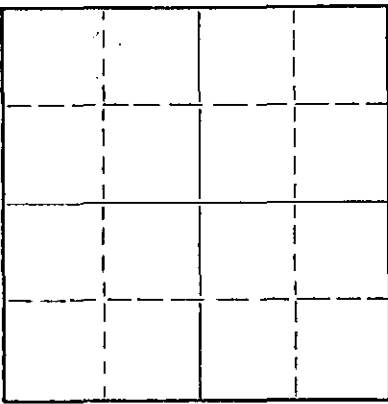

Locate well correctly on above
Section Plat

Barber County, Sec. 24 Twp. 32 Rge. 12 ~~XX~~ (W)
Location as "NE/CNWxSWx" or footage from lines NW NE NW
Lease Owner Aylward Drilling Company
Lease Name Smith Well No. 1
Office Address 813 1st Nat'l Bank Bldg., - Wichita, Kansas
Character of Well (completed as Oil, Gas or Dry Hole) Dry Hole
Date well completed October 2 1955
Application for plugging filed October 2 1955
Application for plugging approved October 2 1955
Plugging commenced October 2 1955
Plugging completed October 2 1955
Reason for abandonment of well or producing formation _____

If a producing well is abandoned, date of last production _____ 19____
Was permission obtained from the Conservation Division or its agents before plugging was commenced? Yes

Name of Conservation Agent who supervised plugging of this well M. A. Rives - Pratt, Kansas
Producing formation _____ Depth to top _____ Bottom _____ Total Depth of Well 4623 Feet
Show depth and thickness of all water, oil and gas formations.

OIL, GAS OR WATER RECORDS

CASING RECORD

FORMATION	CONTENT	FROM	TO	SIZE	PUT IN	PULLED OUT
				8 5/8"	134'	None

Describe in detail the manner in which the well was plugged, indicating where the mud fluid was placed and the method or methods used in introducing it into the hole. If cement or other plugs were used, state the character of same and depth placed, from _____ feet to _____ feet for each plug set.

Hole filled with heavy mud from T. D. to top of surface pipe;
Rigged up swage, mixed 75 sacks cement, and squeezed on top of mud with pump truck.

(If additional description is necessary, use BACK of this sheet)

Name of Plugging Contractor Aylward Drilling Company
Address 813 1st National Bank Bldg. - Wichita, Kansas

STATE OF Kansas, COUNTY OF Sedgwick, ss.
Paul W. Hesse (employee of owner) ~~or (owner or operator)~~ of the above-described well, being first duly sworn on oath, says: That I have knowledge of the facts, statements, and matters herein contained and the log of the above-described well as filed and that the same are true and correct. So help me God.

(Signature) Paul W. Hesse
813 1st National Bank Bldg. - Wichita, Kansas
(Address)

SUBSCRIBED AND SWORN TO before me this 4th day of October, 1955

My commission expires December 11, 1957

Duane Jessup
Duane Jessup - Notary Public.

11-10-55

CONS. DIV. STATE CORP. COM.
WICHITA, KANSAS

PLUGGING
REC 24 T 32 R 12 W
BOOK PAGE 6 LINE 10

SMITH #1

Casing Record:

Company: Aylward Drilling Co. et al
Contractor: Aylward Drilling Company

8-5/8" - 134' cemented with 125 sacks cement

Commenced: September 16, 1955
Completed: October 2, 1955

Location: NW NE NW
Sec. 24-32-12W
Barber County, Kansas

Elevation:
1440 D.F.

	<u>FROM</u>	<u>TO</u>	<u>GEOLOGICAL TOPS</u>	
Sand & Gravel	0	30	Heebner	3506
Red Rock	30	74	Douglas	3522
Red Rock & Shale	74	519	Lansing	3694
Red Bed & Shale	519	1220	Mississippi	4266
Salt	1220	1320	Kinderhook	4426
Anhydrite	1320	1400	Viola	4543
Shale with Lime	1400	1560	Simpson	4620
Lime & Shale	1560	1740	R.T.D.	4623
Lime & Sand	1740	1850		
Sand	1850	1880		
Lime & Sand	1880	1985		
Lime & Shale	1985	2145		
Sand & Shale	2145	2280		
Sandy Lime & Shale	2280	2430		
Sandy Lime & Shale	2430	2745		
Lime & Shale	2745	2865		
Sandy Lime & Shale	2865	2980		
Lime & Sand	2980	3121		
Lime & Shale	3121	3213		
Lime & Shale	3213	3330		
Shale & Sand	3330	3416		
Sand & Shale	3416	3698		
Sand & Lime	3698	3764		
Lime & Shale	3764	3890		
Lime & Sand	3890	3932		
Sand, Lime & Shale	3932	3987		
Lime, Sand & Shale	3987	4016		
Lime	4016	4103		
Lime, Shale & Sand	4103	4172		
Lime & Shale	4172	4238		
Lime & Shale	4238	4286		
Chert & Lime	4286	4328		
Cherty Lime & Shale	4328	4350		
Lime & Shale	4350	4399		
Lime	4399	4420		
Lime & Shale	4420	4484		
Lime & Shale	4484	4521		
Shale & Lime	4521	4550		
Lime & Shale	4550	4580		
Lime	4580	4601		
Lime	4601	4623	R.T.D.	

REMARKS

D.S.T. #1 - 4268-86
Open 2 hours recovered 30' slighty
gas cut mud and 240' of gas, B.H.P. 50#.

D.S.T. #2- 4546-50
Open 1½ hours recovered 30' gas cut mud
390' of gas, B.H.P. 480#.

I certify that this is a true and correct copy of the above log to the best of my knowledge.

Paul W. Hesse
Paul W. Hesse

Subscribed and sworn to before me this 5TH day of OCTOBER, 1955.

Duane Jessup
Duane Jessup
Notary Public

PLUGGING
WICHITA SEC 24 T 32 R 12 W
PAGE 6 LINE 10

My Commission Expires: December 11, 1957: NOV 10 1955

CONSERVATION DIVISION
Wichita, Kansas