


STATE OF KANSAS
STATE CORPORATION COMMISSION

Give All Information Completely
Make Required Affidavit
Mail or Deliver Report to:
Conservation Division
State Corporation Commission
211 No. Broadway
Wichita, Kansas

WELL PLUGGING RECORD

NORTH

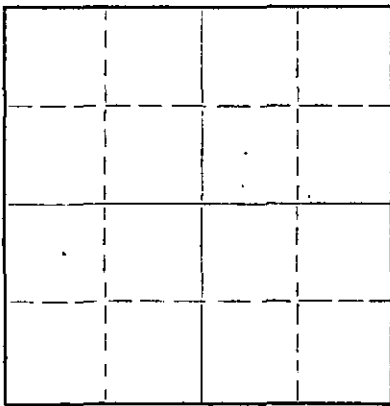

Locate well correctly on above
Section Plat

Barber County. Sec. 22 Twp. 32S Rge. 12 (E) (W)
Location as "NE/CNW&SW" or footage from lines SW SW SE
Lease Owner E. H. Adair, et al.
Lease Name Gillespie Well No. 1
Office Address 1019 East Second Street, Wichita 7, Kansas.
Character of Well (completed as Oil, Gas or Dry Hole) Dry-hole.
Date well completed 7-19- 1956
Application for plugging filed 7-20 1956
Application for plugging approved 7-20 1956
Plugging commenced 7-20 1956
Plugging completed 7-20 1956
Reason for abandonment of well or producing formation Dry-hole

If a producing well is abandoned, date of last production --- 19---
Was permission obtained from the Conservation Division or its agents before plugging was commenced? Yes.

Name of Conservation Agent who supervised plugging of this well M. A. Rives, Box 8, Pratt, Kansas.
Producing formation _____ Depth to top _____ Bottom _____ Total Depth of Well 4751 Feet
Show depth and thickness of all water, oil and gas formations.

OIL, GAS OR WATER RECORDS

CASING RECORD

FORMATION	CONTENT	FROM	TO	SIZE	PUT IN	PULLED OUT
(Copy of Driller's Log attached hereto.)						

Describe in detail the manner in which the well was plugged, indicating where the mud fluid was placed and the method or methods used in introducing it into the hole. If cement or other plugs were used, state the character of same and depth placed, from _____ feet to _____ feet for each plug set.

Placed bottom plug at 200 feet, 20 sacks cement on plug. Filled hole to 30 feet with mud. Placed plug at 30 feet and 10 sacks cement on top-plug. Filled to bottom of cellar.

(If additional description is necessary, use BACK of this sheet)

Name of Plugging Contractor E. H. Adair Oil Company
Address 1019 East Second Street, Wichita 7, Kansas.

STATE OF KANSAS, COUNTY OF SEDGWICK, ss.
K. W. JOHNSON (employee of owner) or (owner or operator) of the above-described well, being first duly sworn on oath, says: That I have knowledge of the facts, statements, and matters herein contained and the log of the above-described well as filed and that the same are true and correct. So help me God.

(Signature) K. W. Johnson
K. W. Johnson.
1019 E. Second St., Wichita 7, Kansas.
(Address)

SUBSCRIBED AND SWORN TO before me this 26th day of July, 1956

My commission expires Sept. 15, 1957.

L. Hill Notary Public.

PLUGGING
FILE SEC. 22 T. 32 R. 12W
307K PAGE 82 LINE 13

7-28-56

E. H. Adair Oil Company
Wichita 7, Kansas.

E. H. Adair Oil Company, et al,
No. 1 Gillespie
SW SW SE of
Sec. 22-Twp. 32 S.-R. 12 West,
Barber County, Kansas.

Comm.: 6-30-56
Comp.: 7-19-56
Contractor:
Adair - Rig No. 3.
8-5/8 @ 205 ft. w/ 175 sx.

Elevation: 1497 K.B.
3 ft. above DF, 9 ft.
above ground.

Pro. D. & A.

Figures indicate bottoms of Formations

Red shale	to 854	Sandy shale	to 3746
Shale	1475	Lime	4341
Lime	2250	Chert & little lime	4446
Lime & shale	3200	Chert	4459
Lime	3255	Lime, cherty	4498
Shale	3351	Shale	4604
Lime	3360	Cherty Dolomite	4708
Shaley lime	3388	Shale	4712
Shale	3515	Shaley & sandy	
Shale & lime strks.	3573	Dolomite	4728
Sand	3710	Sand & Dolomite sand	4751
		T.D.	4751

Certified correct:

K. W. Johnson
K. W. Johnson - Geologist.

RECEIVED
THE CORPORATION COMMISSION
JUL 27 1956
OIL AND GAS DIVISION

PLUGGING
FILE SEC 22 T 32 R 12W
BOOK PAGE 82 LINE 13