


WELL PLUGGING RECORD

Give All Information Completely
Make Required Affidavit
Mail or Deliver Report to:
Conservation Division
State Corporation Commission
211 No. Broadway
Wichita, Kansas

Barber

County. Sec. 21 Twp. 32 Rge. (E) 12 (W)

NORTH

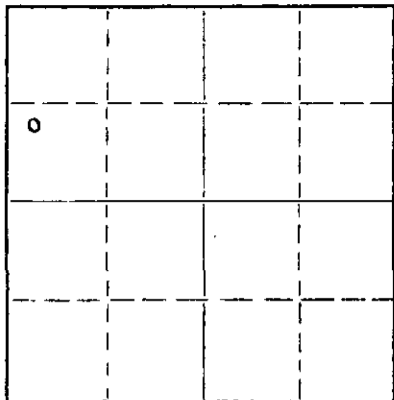

Locate well correctly on above Section Plat

Location as "NE/CNW%SW%" or footage from lines NW SW NW
Lease Owner Globe Oil & Refining Co.
Lease Name Kirkbride Well No. 1
Office Address 301 South Market, Wichita 13, Kansas
Character of Well (completed as Oil, Gas or Dry Hole) Dry Hole
Date well completed February 14, 19 57
Application for plugging filed (verbal) February 14, 19 57
Application for plugging approved February 14, 19 57
Plugging commenced February 14, 19 57
Plugging completed February 14, 19 57
Reason for abandonment of well or producing formation Dry Hole

If a producing well is abandoned, date of last production _____ 19____
Was permission obtained from the Conservation Division or its agents before plugging was commenced? Yes

Name of Conservation Agent who supervised plugging of this well Merle A. Rives
Producing formation _____ Depth to top _____ Bottom _____ Total Depth of Well 4457 Feet
Show depth and thickness of all water, oil and gas formations.

OIL, GAS OR WATER RECORDS

CASING RECORD

FORMATION	CONTENT	FROM	TO	SIZE	PUT IN	PULLED OUT
				8 5/8"	304	None

Describe in detail the manner in which the well was plugged, indicating where the mud fluid was placed and the method or methods used in introducing it into the hole. If cement or other plugs were used, state the character of same and depth placed, from _____ feet to _____ feet for each plug set.

Hole filled with mud from 4457 to 250'. Plug set at 250' with 20 sacks cement, then mud to 35'. Plug set at 35' with 10 sacks cement to top of surface pipe.

(If additional description is necessary, use BACK of this sheet)

Name of Plugging Contractor Sterling Drilling Co.
Address Sterling, Kansas

STATE OF Kansas, COUNTY OF Sedgwick, ss.
Leo Ross (employee of owner) or (owner or operator) of the above-described well, being first duly sworn on oath, says: That I have knowledge of the facts, statements, and matters herein contained and the log of the above-described well as filed and that the same are true and correct. So help me God.

(Signature) [Signature]
301 South Market, Wichita, Kansas
(Address)

SUBSCRIBED AND SWORN TO before me this 18th day of February, 19 57

My commission expires July 21, 1958

RECEIVED
STATE CORPORATION COMMISSION
Notary Public.

FEB 19 1957
PLUGGING
FILE SEC. 21, T. 32, R. 12W
BOOK PAGE 141, LINE 18

GLOBE OIL & REFINING CO.
 No. 1 Kirkbride
 NW SW NW Sec. 21-32S-12W
 Barber County, Kansas

Date Commenced: January 29, 1957
 Date Completed: February 14, 1957
 Drilling Contractor: Group Exploration Co.
 T.D. - 4457 feet
 I.P. - Dry and Abandoned

<u>Formation</u>	<u>Depth</u>
Soil and rock	100
Shale	302
Shale & shells	1410
Shale & lime	1810
Lime	2480
Lime & shale	3170
Lime	3270
Lime & shale	3540
Shale & shells	3600
Shale, shells & sand	3620
Lime & shale	3685
Lime	3740
K.C. lime	3805
Lime	4300
Shale & lime	4375
Mississippi Chert	4415
Lime	4457

Casing Record:

8 5/8" 304.65' set @ 302'
 cem. 250 sxs.

Geological Tops - R.B. Meas.

Lansing	3825
Base K.C.	4243
Mississippi Chat	4375
Mississippi Lime	4442

PLUGGING
 FILE SEC. 21 T. 32 R. 12 W
 BOOK PAGE 141 LINE 18

RECEIVED
 STATE CORPORATION